

CARROLL

MISSISSIPPI BOARD OF WATER COMMISSIONERS

M1 E-log # 14
5-11-62


WATER WELL DRILLERS LOG

M

CO D K CODED

Date: MAY 11, 1962, Driller: DELTA DRILLING County CARROLL
(Name)

	Description & Color of Materials Sand, Clay, Red Clay, Shell, etc.	Thick- ness Feet	Depth Feet
(1) Owner of Land: <u>W. H. MORGAN</u> <u>MORGAN CITY, MISS.</u> WELL LOCATION: <u>BLACK HAWK, MISS</u> (Name) (Address)	CLAY	21	21
(2) Location: <u>NE 1/4, NE 1/4, Sec. 32 T4R3E</u> <u>2 miles SOUTH of BLACK HAWK</u> (distance) (direction) (Nearest Town)	GRAVEL	46	67
(3) Topography: <u>HILLY</u> (Hilly) (Flat) (Level)	SHALE	38	105
(4) Purpose of Well: <u>DOMESTIC</u> (Domestic Irrigation Municipal, Industrial, Other)	SAND	40	145
Information upon completion of well:	GRAVEL	21	166
(1) Diameter <u>4</u> inches.	SHALE CODED	20	186
(2) Total Depth <u>552</u> feet.	GRAVEL	10	196
(3) Water Level <u>154</u> feet below top of ground.	SAND	16	212
(4) Cased to <u>552</u> , Size <u>4 x 2</u> .	SAND-	37	249
(5) Screen: Size <u>20"</u> , Length <u>10'</u> .	CLAY	31	280
(6) Were any formations sealed against pollution? _____ yes, <input checked="" type="checkbox"/> no.	SAND	20	300
If YES depth of formation _____	CLAY	20	320
Why _____	SAND	22	342
Drillers Remarks: <u>DEEP WELL SUBMER- SIBLE RED JACKET PUMP INSTALLED IN WELL W/178'- PUMP SETTING-</u>	CLAY	10	352
	SHALE W/1" ROCK-	78	430
	BROWN SAND W/5" ROCK	28	458
	GREEN SAND	94	552

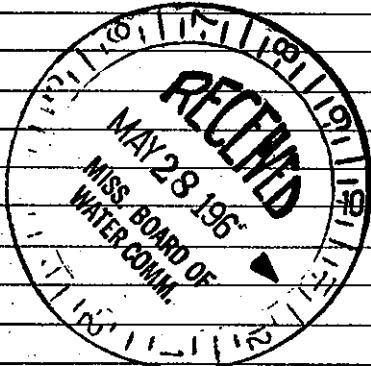

CODED

(Use Back Side)

Well No.

Mail this copy to Board of Water Commissioners 429 Miss. St. Jackson, Miss