

CARROLL MISSISSIPPI BOARD OF WATER COMMISSIONERS

MV E109 # 25

Coded

WATER WELL DRILLERS LOG

CODED

12-29-64

Date: DEC. 29, 1964, Driller: DELTA DRILLING CO. County CARROLL

(Name)

(1) Owner of Land: W.S. COOPER
(Name)
WELL LOCATED IN
CARROLL COUNTY
(Address)

(2) Location: NW 1/4, NW 1/4, Sec. 24 T17N R3E
0 F 5 E 1/4
 _____ miles _____ of _____
(distance) (direction) (Nearest Town)

(3) Topography: _____
(Hilly) (Flat) (Level)

(4) Purpose of Well: DOMESTIC
(Domestic Irrigation
 Municipal, Industrial, Other)

Description & Color of Materials Sand, Clay, Red Clay, Shell, etc.	Thick- ness Feet	Depth Feet
CLAY	151	151
SHALE	23	174
SAND	20	194
SHALE W/ROCK	84	278
SAND	64	342
CODED		
CODED		

Information upon completion of well:

(1) Diameter 4 inches.

(2) Total Depth 342 feet.

(3) Water Level _____ feet below top of ground.

(4) Cased to 322', Size 250'-4", 72'-2"


(5) Screen: Size 2", Length 20'

(6) Were any formations sealed against pollution?
 _____ yes, _____ no.

If YES depth of formation _____

Why _____

Drillers Remarks: _____

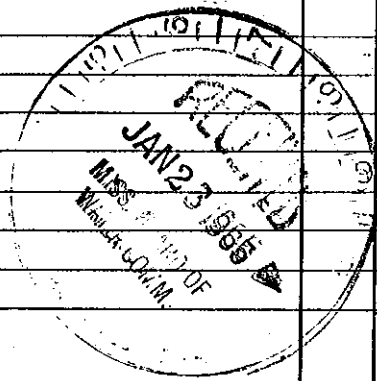

(Use Back Side)

Well No.

Mail this copy to Board of Water Commissioners 429 Miss. St. Jackson, Miss