

CARROLL

MS

2-68

MISS-Geo

February 1968
date well completed

MISSISSIPPI
BOARD OF WATER COMMISSIONERS
416 North State Street
Jackson, Mississippi 39201

CODED

WATER WELL DRILLERS LOG

Robert E. Rattiff Co. Carroll
firm name county well located

LANDOWNER:

Black Hawk Water Co.
Black Hawk, Miss
(mailing address)

description of formations encountered

from to

Dirt + clay	1	45
Sand + gravel	45	90
clay	90	180
clay	180	230
Brackd Shale	230	260
Shale	260	325
Green Sand	325	350
Green Sand	350	409
Sand + Shale	409	535
Shale	535	800
Sand + Shale	800	825
Shale	825	920
Sand	920	990
Shale	990	1006

WELL LOCATION:

sec. 20 T. 17 N. R. 3 E.
15 miles No. of Depinto
(distance) (direction) (nearest town)

WELL PURPOSE:


(home, irrigation, municipal, industrial)

WELL COMPLETION DATA:

- (1) diameter (inches) 6 x 3
- (2) total depth (feet) 986
- (3) static water level (feet) 90 below above
top of ground.
- (4) casing Bl. Steel, 946
(material) (depth)
6 x 3 (size) If telescope see back.
- (5) screen 40', 946
(length) (depth to top)
3" Stainw Steel
(size) (material)
- (6) pump 10 50
(HP) (yield gpm)
Electrical
(type power)
- (7) electric log Yes
(yes or no)
Miss Geo -
(organization running log)
- (8) how well bottom plugged Back
Pressure Valve

CODED

CODED

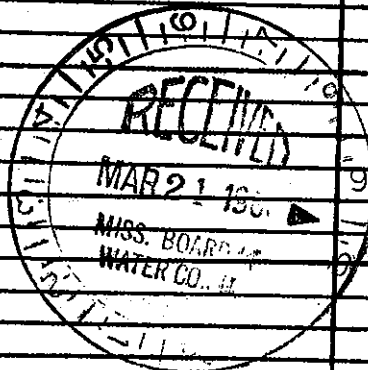

DRILLERS REMARKS: