

CARROLL

M

MISSISSIPPI BOARD OF WATER COMMISSIONERS

4-30-62

WATER WELL DRILLERS LOG

Carroll

Date: 4-30, 1962, Driller: Jack Martin County: Holms

(Name)


(1) Owner of Land:	Description & Color of Materials Sand, Clay, Red Clay, Shell, etc.	Thick- ness Feet	Depth Feet
R. D. Farnish (Name) Coila (Address)	Top clay	21	21
(2) Location: NW 1/4, SW 1/4, Sec. 22 T17R3E,	Pipe clay & sand	5	26
3 miles East of Black Hawk (distance) (direction) (Nearest Town)	Sand	9	35
(3) Topography: Hilly (Hilly) (Flat) (Level)	Pipe clay	3	38
(4) Purpose of Well: Domestic (Domestic Irrigation Municipal, Industrial, Other)	SAND (7170)	18	56
	Sand	34	90

CODED

Information upon completion of well:

- (1) Diameter 2 inches.
- (2) Total Depth 89 feet.
- (3) Water Level 5-5 feet below top of ground.
- (4) Cased to 84, Size 2
- (5) Screen: Size 2", Length 5 ft.
- (6) Were any formations sealed against pollution?
yes, no.

CODED

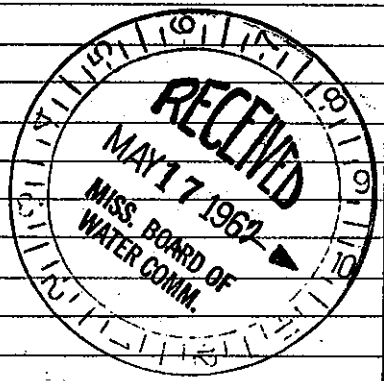

If YES depth of formation _____

Why _____

Drillers Remarks: _____

Well

(Use Back Side)

Mail this copy to Board of Water Commissioners 429 Miss. St. Jackson,