

CARROLL MISSISSIPPI BOARD OF WATER COMMISSIONERS

M 22

WATER WELL DRILLERS LOG

8-23-60

M300

Date: 8-23, 1960, Driller: Jack Martin Holmes County: Carroll  
(Name)

(1) Owner of Land: S. H. Robertson  
(Name)

(2) Location: SW 1/4, NE 1/4, Sec. 6 T17R3

16 miles SW of Carrollton  
(distance) (direction) (Nearest Town)

(3) Topography: Hilly  
(Hilly) (Flat) (Level)

(4) Purpose of Well: Domestic  
(Domestic Irrigation Municipal, Industrial, Other)

Description & Color of Materials Sand, Clay, Red Clay, Shell, etc.	Thick- ness Feet	Depth Feet
<u>Red clay</u>	<u>22</u>	<u>22</u>
<u>Sand - gravel</u>	<u>6</u>	<u>28</u>
<u>Pipe clay</u>	<u>7</u>	<u>35</u>
<u>Sand</u>	<u>5</u>	<u>40</u>
<u>Pipe clay</u>	<u>4</u>	<u>44</u>
<u>Sand</u>	<u>70</u>	<u>114</u>

Information upon completion of well:

(1) Diameter 2 inches.

(2) Total Depth 109 feet.

(3) Water Level \_\_\_\_\_ feet below top of ground.

(4) Cased to 104, Size 2"

(5) Screen: Size 2", Length 5'

(6) Were any formations sealed against pollution?  
 \_\_\_\_\_ yes,  no.


If YES depth of formation \_\_\_\_\_

Why \_\_\_\_\_

Drillers Remarks: \_\_\_\_\_

CODED

CODED

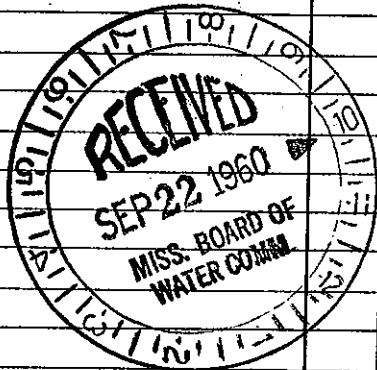

Well No.

(Use Back Side)

Mail this copy to Board of Water Commissioners 429 Miss. St. Jackson, Miss.