

CARROLL MISSISSIPPI BOARD OF WATER COMMISSION

M 24
2-61

WATER WELL DRILLERS LOG

CODED

M 301

Date: Feb, 1961, Driller: Jack Martin County Carroll

(Name)

(1) Owner of Land: <u>Miss Ella R. Streets</u> (Name)	Description & Color of Materials Sand, Clay, Red Clay, Shell, etc.	Thick- ness Feet	Depth Feet
<u>Black Hawk Miss</u> (Address)	<u>Clay</u>	<u>21</u>	<u>21</u>
	<u>Sand</u>	<u>25</u>	<u>46</u>
(2) Location: <u>SW 1/4, SW 1/4, Sec. 17 T17R32</u>	<u>Sand & Gravel</u>	<u>18</u>	<u>64</u>
<u>at Black Hawk</u> (distance) (direction) (Nearest Town)	<u>Sand</u>	<u>16</u>	<u>80</u>
(3) Topography: <u>Hilly</u> (Hilly) (Flat) (Level)			
(4) Purpose of Well: <u>Domestic</u> (Domestic Irrigation Municipal, Industrial, Other)			

CODED

Information upon completion of well:


- (1) Diameter 2 inches.
- (2) Total Depth 74 feet.
- (3) Water Level _____ feet below top of ground.
- (4) Cased to 69, Size 2
- (5) Screen: Size 2, Length 5
- (6) Were any formations sealed against pollution?
_____ yes, no.

CODED

If YES depth of formation _____

Why _____

Drillers Remarks: _____

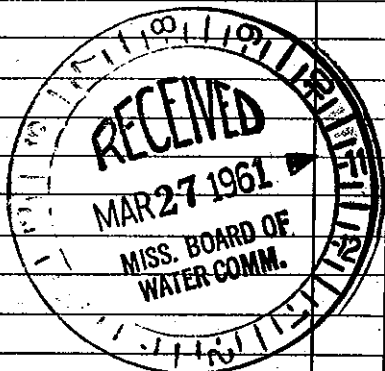

Well No.

(Use Back Side)

Mail this copy to Board of Water Commissioners 429 Miss. St. Jackson, Miss.