

CARROLL

MISSISSIPPI BOARD OF WATER COMMISSIONERS

M 26

7-62

WATER WELL DRILLERS LOG

Date: July, 1962, Driller: Jack Martin County Carroll (Name)

(1) Owner of Land:	Description & Color of Materials Sand, Clay, Red Clay, Shell, etc.	Thick- ness Feet	Depth Feet
J.R. Funderburk (Name) Poila (Address)	top clay	19	19
(2) Location: NW 1/4, NW 1/4, Sec. 8 T17R3E	Pipe clay - l sand	25	44
3 miles NW, of Black Hawk (distance) (direction) (Nearest Town)	Gravel & Sand	51	95
(3) Topography: Hilly (Hilly) (Flat) (Level)	Sand	4	136
(4) Purpose of Well: Domestic (Domestic Irrigation, Municipal, Industrial, Other)			

Information upon completion of well:

- (1) Diameter 2 inches.
- (2) Total Depth 136 feet.
- (3) Water Level 90 feet below top of ground.
- (4) Cased to 131, Size 2
- (5) Screen: Size 2", Length 5'
- (6) Were any formations sealed against pollution?
 yes, no.


If YES depth of formation _____

Why _____

Drillers Remarks: _____

CODED

CODED

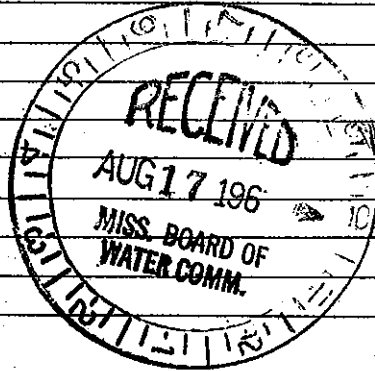

(Use Back Side)

Well No.

Mail this copy to Board of Water Commissioners 429 Miss. St. Jackson, Miss