

CARROLL MISSISSIPPI BOARD OF WATER COMMISSIONERS

M 28  
1-64

WATER WELL DRILLERS LOG

Date: Jan, 1964 Driller: Jack Mather County Nelms  
(Name)


	Description & Color of Materials Sand, Clay, Red Clay, Shell, etc.	Thick- ness Feet	Depth Feet
(1) Owner of Land: <u>Mr Kitchens</u> (Name) <u>Black Hawk</u> (Address)	<u>clay</u>	<u>12</u>	<u>12</u>
(2) Location: <u>NE 1/4, NW 1/4, Sec. 20 T17R3E</u> <u>In Black Hawk</u> (distance) (direction) (Nearest Town)	<u>Sand</u>	<u>43</u>	<u>55</u>
(2) Location: <u>NE 1/4, NW 1/4, Sec. 20 T17R3E</u> <u>In Black Hawk</u> (distance) (direction) (Nearest Town)	<u>Sand gravel</u>	<u>18</u>	<u>73</u>
(3) Topography: <u>Hilly</u> (Hilly) (Flat) (Level)	<u>Sand</u>	<u>16</u>	<u>89</u>
(4) Purpose of Well: <u>Domestic</u> (Domestic Irrigation Municipal, Industrial, Other)			

Information upon completion of well:

- (1) Diameter 2 inches.
- (2) Total Depth 89 feet.
- (3) Water Level 65 feet below top of ground.
- (4) Cased to 84, Size 2
- (5) Screen: Size 2, Length 5
- (6) Were any formations sealed against pollution?  
no

CODED

CODED

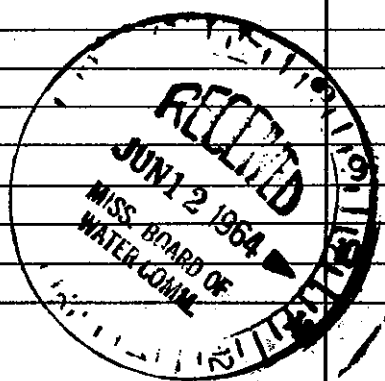

Well No.

(Use Back Side)

Mail this copy to Board of Water Commissioners 429 Miss. St. Jackson, Miss.