

CARROLL MISSISSIPPI BOARD OF WATER COMMISSIONERS

M 29

8-64

WATER WELL DRILLERS LOG

Date: Aug, 1964, Driller: Jack Martin County Holmes

(Name)

(1) Owner of Land:	Description & Color of Materials Sand, Clay, Red Clay, Shell, etc.	Thick- ness Feet	Depth Feet
Emmettes Fancher (Name)	Clay	21	21
Caila (Address)	Sand - Pipe Clay	35	56
(2) Location: NE 1/4, NE 1/4, Sec. 18 T17R3E,	Sand - Gravel	6	62
1 1/2 miles NW, of Black Hawk	Sand	40	102
(distance) (direction) (Nearest Town)	Sand - Gravel	34	136
(3) Topography: Willy	Sand	15	151
(Hilly) (Flat) (Level)			
(4) Purpose of Well: Domestic			
(Domestic Irrigation Municipal, Industrial, Other)			

CODED

Information upon completion of well:


- (1) Diameter 2 inches.
- (2) Total Depth 151 feet.
- (3) Water Level 118 feet below top of ground.
- (4) Cased to 146, Size 2.
- (5) Screen: Size 2", Length 5'.
- (6) Were any formations sealed against pollution?
 yes, no.

CODED

If YES depth of formation _____

Why _____

Drillers Remarks: _____

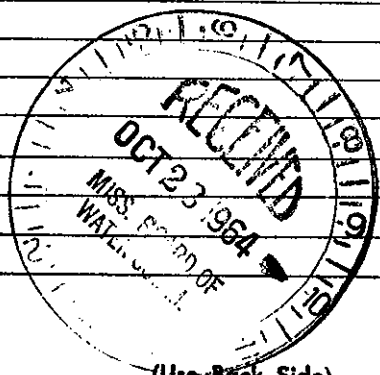

(Use Back Side)

Well No.

Mail this copy to Board of Water Commissioners 429 Miss. St. Jackson, Miss