

CARROLL MISSISSIPPI BOARD OF WATER COMMISSIONERS

M 30
1-65

WATER WELL DRILLERS LOG

Date: Jan, 1965, Driller: Jack Martin County Holmes
(Name)

(1) Owner of Land: Walter Elliot
(Name)
Coila
(Address)

(2) Location: SW 1/4, NW 1/4, Sec. 6 T17R3E,
3 miles NW of Black Hawk
(distance) (direction) (Nearest Town)

(3) Topography: Hilly
(Hilly) (Flat) (Level)

(4) Purpose of Well: Domestic
(Domestic Irrigation
Municipal, Industrial, Other)

Description & Color of Materials Sand, Clay, Red Clay, Shell, etc.	Thick- ness Feet	Depth Feet
<u>Clay</u>	<u>19</u>	<u>19</u>
<u>Sand - Gravel</u>	<u>18</u>	<u>37</u>
<u>Pipe Clay</u>	<u>5</u>	<u>42</u>
<u>Sand</u>	<u>31</u>	<u>73</u>
<u>Mud</u>	<u>11</u>	<u>84</u>
<u>Sand</u>	<u>57</u>	<u>141</u>

Information upon completion of well:

(1) Diameter 2 inches.

(2) Total Depth 141 feet.

(3) Water Level 90 feet below top of ground.

(4) Cased to 136, Size 2

(5) Screen: Size 2, Length 5

(6) Were any formations sealed against pollution?
_____ yes, _____ no.


CODED

CODED

If YES depth of formation _____

Why _____

Drillers Remarks: _____

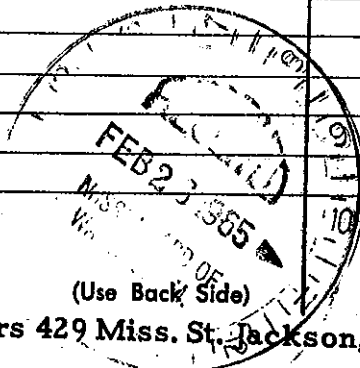

Well No.

Mail this copy to Board of Water Commissioners 429 Miss. St. Jackson, Miss