

CARROLL MISSISSIPPI BOARD OF WATER COMMISSIONERS

M 32

2-66


WATER WELL DRILLERS LOG

Date: Feb, 19 66, Driller: Jack Martin County Holmes
(Name)

(1) Owner of Land: <u>Morgan Guley</u> (Name) <u>Black Hawk</u> (Address)	Description & Color of Materials Sand, Clay, Red Clay, Shell, etc.	Thick- ness Feet	Depth Feet
	<u>Clay</u>	<u>22</u>	<u>22</u>
(2) Location: <u>NW 1/4, NW 1/4, Sec 20 T17R3E</u> <u>in Black Hawk</u> (distance) (direction) (Nearest Town)	<u>Sand Gravel</u>	<u>42</u>	<u>64</u>
	<u>Sand</u>	<u>25</u>	<u>89</u>
(3) Topography: <u>Hilly</u> (Hilly) (Flat) (Level)			
(4) Purpose of Well: <u>Domestic</u> (Domestic Irrigation Municipal, Industrial, Other)			
Information upon completion of well:			
(1) Diameter <u>2</u> inches.			
(2) Total Depth <u>89</u> feet.			
(3) Water Level <u>51</u> feet below top of ground.			
(4) Cased to <u>84</u> , Size <u>2</u>			
(5) Screen: Size <u>2</u> , Length <u>5</u>			
(6) Were any formations sealed against pollution? _____ yes, _____ no.			
If YES depth of formation _____			
Why _____			
Drillers Remarks: _____			

CODED

CODED

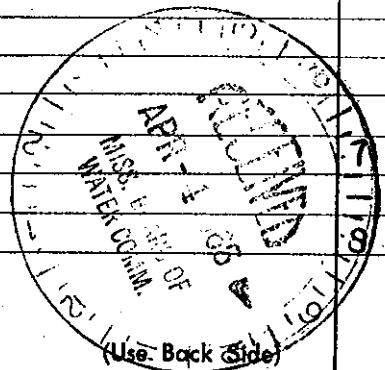

Well No.

Mail this copy to Board of Water Commissioners 429 Miss. St. Jackson, Miss