

CARROLL
M 33

MISSISSIPPI BOARD OF WATER COMMISSIONERS


7-66

WATER WELL DRILLERS LOG

Carroll

Date: July, 1966, Driller: Jack Martin County Holmes
(Name)

(1) Owner of Land:	Description & Color of Materials Sand, Clay, Red Clay, Shell, etc.	Thick- ness Feet	Depth Feet
<u>Morgan Gailley</u> (Name) <u>Black Hawk Gen Del</u> (Address)	<u>Clay CODED</u>	14	14
(2) Location: <u>NE 1/4, SE 1/4, Sec. 30 T17R2E</u>	<u>pipe clay</u>	8	22
<u>1 1/2 miles South</u> , of <u>Black Hawk</u> (distance) (direction) (Nearest Town)	<u>Sand</u>	23	45
(3) Topography: <u>Hilly</u> (Hilly) (Flat) (Level)	<u>Sand & Gravel</u>	10	55
(4) Purpose of Well: <u>Domestic</u> (Domestic Irrigation Municipal, Industrial, Other)	<u>sand</u>	27	82
Information upon completion of well:	<u>Sand & Gravel</u>	13	95
(1) Diameter <u>2</u> inches.	<u>Sand (pipe clay streak)</u>	25	120
(2) Total Depth <u>152</u> feet.	<u>Sand</u>	32	152
(3) Water Level <u>85</u> feet below top of ground.	<u>CODED</u>		
(4) Cased to <u>147</u> , Size <u>2</u>			
(5) Screen: Size <u>2</u> , Length <u>5</u>			
(6) Were any formations sealed against pollution? <u>yes</u> , <input checked="" type="checkbox"/> no.			
If YES depth of formation _____			
Why _____			
Drillers Remarks: _____			

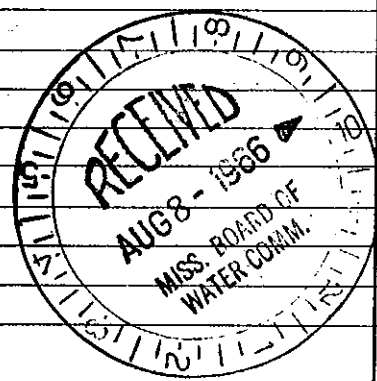

(Use Back Side)

Well No.

Mail this copy to Board of Water Commissioners 429 Miss. St. Jackson, Miss.