

Carroll  
 M 35  
 9-67

MISSISSIPPI  
 BOARD OF WATER COMMISSIONERS  
 416 North State Street  
 Jackson, Mississippi 39201

WATER WELL DRILLERS LOG

Sept 19 67 date well completed  
 Jack Martin firm name  
 Carroll county well located

LANDOWNER: Mrs Ruby Baley  
 Coila Rt # 1  
 (mailing address)

description of formations encountered	from	to
Clay	0	18
prpl Clay	18	24
Sand	24	39
Sand + Gravel	39	97
Sand	97	142


WELL LOCATION:  
 sec. 5 T. 17 N R. 3 E  
 2 1/2 miles N of Black Hawk  
 (distance) (direction) (nearest town)

WELL PURPOSE: Home  
 (home, irrigation, municipal, industrial)

- WELL COMPLETION DATA:
- diameter (inches) 2
  - total depth (feet) 142
  - static water level (feet) 104 below top of ground
  - casing (material) steel (depth) 137  
 2 (size) If telescope see back.
  - screen (length) 5 (depth to top) 137  
 2 (size) Stainless Steel (material)
  - pump (HP) 3/4 (yield gpm) 3  
 Electric (type power)
  - electric log (yes or no) No
  - (organization running log)
  - how well bottom plugged Cap

CODED

CODED

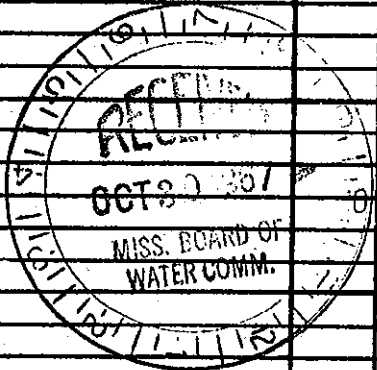

DRILLERS REMARKS: