

CARROLL
 N 9
 12/73
 E 69# 64


MISSISSIPPI
 BOARD OF WATER COMMISSIONERS
 416 North State Street
 Jackson, Mississippi 39201

WATER WELL DRILLERS LOG CODED

date well completed 19 Delta Drilling firm name Carroll county well located

LANDOWNER:	description of formations encountered	from	to
MA. B. B. SANDERS Box 196 VAIDEN, MISS (mailing address)			
WELL LOCATION: sec. 13 T. 12 N R. 4 E S W 4 1/2 miles W of VAIDEN (distance) (direction) (nearest town)	SHALE	151	172
WELL PURPOSE: (home, irrigation, municipal, industrial)	SAND	172	203
WELL COMPLETION DATA: (1) diameter (inches) 4 1/2	SAND loam lo	203	294
(2) total depth (feet)	SAND	294	328
(3) static water level (feet) 158' below top of ground		328	435
(4) casing <u>steel</u> 435 (material) (depth)			
(5) screen 110' 346' (length) (depth to top)			
(6) pump 1 1/2 (HP) (yield gpm)			
(7) electric log YES (yes or no)			
(8) how well bottom plugged BACK PRESSURE VALVE			
DRILLERS REMARKS:			

CODED

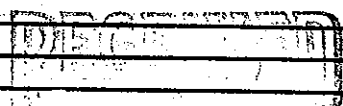

JAN 10 1974

MISS. BD. OF WATER COMMISSIONERS