

CARROLL MISSISSIPPI BOARD OF WATER COMMISSIONERS


N 12

2-63

WATER WELL DRILLERS LOG

Date: Feb, 1963, Driller: Jack Martin County Carroll
(Name)

(1) Owner of Land: <u>Claud Cox</u> <small>(Name)</small>	Description & Color of Materials Sand, Clay, Red Clay, Shell, etc.	Thick- ness Feet	Depth Feet
<u>Varden</u> <small>(Address)</small>	<u>Top Clay (rocks)</u>	<u>10</u>	<u>10</u>
(2) Location: <u>NE 1/4, SE 1/4, Sec. 32 T17R4E</u>	<u>Sand (rock layer)</u>	<u>14</u>	<u>24</u>
<u>8</u> miles <u>SW</u> of <u>Varden</u> <small>(distance) (direction) (Nearest Town)</small>	<u>Sand & Pipe clay</u>	<u>44</u>	<u>68</u>
(3) Topography: <u>Hilly</u> <small>(Hilly) (Flat) (Level)</small>	<u>Sand</u>	<u>26</u>	<u>94</u>
(4) Purpose of Well: <u>Domestic</u> <small>(Domestic Irrigation, Municipal, Industrial, Other)</small>	CODED.		
Information upon completion of well:			
(1) Diameter <u>2</u> inches.			
(2) Total Depth <u>94</u> feet.			
(3) Water Level <u>66</u> feet below top of ground.			
(4) Cased to <u>89</u> , Size <u>2</u>			
(5) Screen: Size <u>2</u> , Length <u>5</u>			
(6) Were any formations sealed against pollution? _____yes, _____no.			
If YES depth of formation _____			
Why _____			
Drillers Remarks: _____			

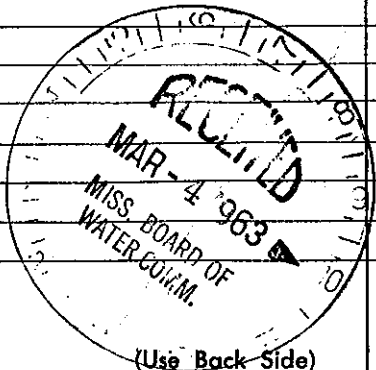

Well No.

Mail this copy to Board of Water Commissioners 429 Miss. St. Jackson, Miss.