

CARROLL MISSISSIPPI BOARD OF WATER COMMISSIONERS

N 13

10-63


WATER WELL DRILLERS LOG

Date: Oct, 1963, Driller: Jack Martin County Waller
(Name)

	Description & Color of Materials Sand, Clay, Red Clay, Shell, etc.	Thick- ness Feet	Depth Feet
(1) Owner of Land: <u>Will Vance</u> <small>(Name)</small>			
<u>Warden</u> <small>(Address)</small>			
(2) Location: <u>NW 1/4, SW 1/4, Sec. 10 T17R4E</u>			
<u>10</u> miles <u>West</u> , of <u>Warden</u> <small>(distance) (direction) (Nearest Town)</small>			
(3) Topography: <u>Hilly</u> <small>(Hilly) (Flat) (Level)</small>			
(4) Purpose of Well: <u>Domestic</u> <small>(Domestic Irrigation Municipal, Industrial, Other)</small>			
Information upon completion of well:			
(1) Diameter <u>2</u> inches.			
(2) Total Depth <u>194</u> feet.			
(3) Water Level <u>115</u> feet below top of ground.			
(4) Cased to <u>189</u> , Size <u>2</u>			
(5) Screen: Size <u>2</u> , Length <u>5'</u>			
(6) Were any formations sealed against pollution? _____yes, _____no.			
If YES depth of formation _____			
Why _____			
Drillers Remarks: _____			

CODED

CODED

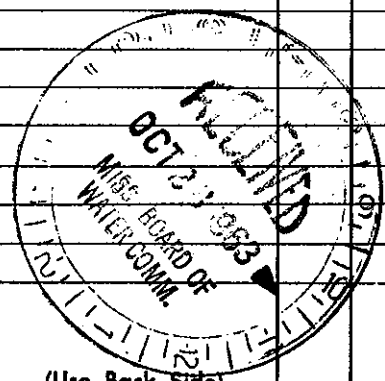

(Use Back Side)

Well No.

Mail this copy to Board of Water Commissioners 429 Miss. St. Jackson, Miss.