

GARROLL

MISSISSIPPI BOARD OF WATER COMMISSIONERS

N 14
5-65

WATER WELL DRILLERS LOG

Date: May, 1965, Driller: Jack Martin County Nalmea
(Name)

(1) Owner of Land:	Description & Color of Materials Sand, Clay, Red Clay, Shell, etc.	Thick- ness Feet	Depth Feet
<u>Harrison Farms</u> (Name) <u>Vaiden</u> (Address)	<u>Clay</u>	<u>8</u>	<u>8</u>
(2) Location: <u>NW 1/4, NW 1/4, Sec. 11, T17R4E</u>	<u>Red Sand</u>	<u>8</u>	<u>16</u>
<u>7</u> miles <u>W</u> , of <u>Vaiden</u> (distance) (direction) (Nearest Town)	<u>Pipe Clay</u>	<u>5</u>	<u>21</u>
(3) Topography: <u>Hilly</u> (Hilly) (Flat) (Level)	<u>Sand - pipe Clay</u>	<u>24</u>	<u>105</u>
(4) Purpose of Well: <u>Domestic</u> (Domestic Irrigation Municipal, Industrial, Other)	<u>Sand</u>	<u>59</u>	<u>164</u>


Information upon completion of well:

- (1) Diameter 2 inches.
- (2) Total Depth 164 feet.
- (3) Water Level 90 feet below top of ground.
- (4) Cased to 159, Size 2
- (5) Screen: Size 2, Length 5
- (6) Were any formations sealed against pollution?
_____ yes, _____ no.

If YES depth of formation _____

Why _____

Drillers Remarks: _____

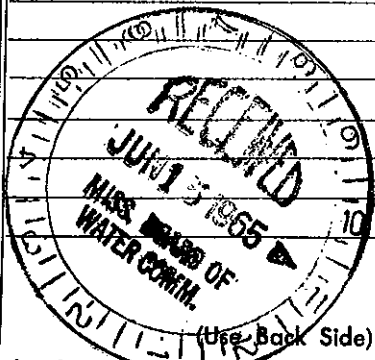

Well No.

Mail this copy to Board of Water Commissioners 429 Miss. St. Jackson, Miss.