

Carroll
N 16
10-66

MISSISSIPPI BOARD OF WATER COMMISSIONERS

WATER WELL DRILLERS LOG

Date: 10-20, 1966, Driller: Butane Gas Co. County: Carroll
(Name)

(1) Owner of Land:	Description & Color of Materials Sand, Clay, Red Clay, Shell, etc.	Thick- ness Feet	Depth Feet
<u>Wm. William</u> (Name) <u>Rt. 3, Winona, Miss.</u> (Address)	<u>Clay</u>	<u>18</u>	<u>18</u>
(2) Location: <u>NE 1/4, SE 1/4, Sec. 11 T17R4E</u> <u>6</u> miles <u>W</u> of <u>Uiden</u> (distance) (direction) (Nearest Town)	<u>Sand + Clay</u>	<u>62</u>	<u>80</u>
(3) Topography: <input checked="" type="checkbox"/> (Hilly) <input type="checkbox"/> (Flat) <input type="checkbox"/> (Level)	<u>Sand</u>	<u>25</u>	<u>105</u>
(4) Purpose of Well: <u>Domestic</u> (Domestic Irrigation Municipal, Industrial, Other)			

Information upon completion of well:

- (1) Diameter: 4 3/4 inches.
- (2) Total Depth: 105 feet.
- (3) Water Level: 2' 6" feet below top of ground.
- (4) Cased to: 94, Size: 2"
- (5) Screen: Size: 2", Length: 10'
- (6) Were any formations sealed against pollution?
 yes, no.


If YES depth of formation _____

Why _____

Drillers Remarks: _____

CODED

CODED

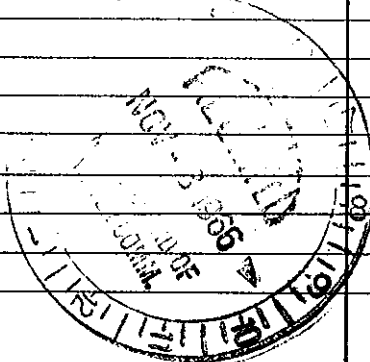

(Use Back Side)

Well No.

Mail this copy to Board of Water Commissioners 429 Miss. St. Jackson, Miss.