

Carroll
N 17
10-66

MISSISSIPPI BOARD OF WATER COMMISSIONERS

WATER WELL DRILLERS LOG

Date: 10-22, 1966, Driller: Butane Gas Co. County Carroll
(Name)


(1) Owner of Land: <u>Guy C. Billups</u> (Name)	Description & Color of Materials Sand, Clay, Red Clay, Shell, etc.	Thick- ness Feet	Depth Feet
<u>Rt. 3, Winona, Miss.</u> (Address)	<u>Clay</u>	<u>18</u>	<u>18</u>
(2) Location: <u>NE 1/4, SE 1/4, Sec. 11 T. 17 R. 4 E.</u>	<u>Sand + Clay</u>	<u>62</u>	<u>80</u>
<u>6</u> miles <u>W</u> of <u>Under</u> (distance) (direction) (Nearest Town)	<u>Sand</u>	<u>31</u>	<u>111</u>
(3) Topography: <input checked="" type="checkbox"/> (Hilly) <input type="checkbox"/> (Flat) <input type="checkbox"/> (Level)			
(4) Purpose of Well: (Domestic Irrigation, Municipal, Industrial, Other)			

CODED

Information upon completion of well:

- (1) Diameter 4 3/4 inches.
- (2) Total Depth 111 feet.
- (3) Water Level 40' feet below top of ground.
- (4) Cased to 109, Size 2"
- (5) Screen: Size 2", Length 10'
- (6) Were any formations sealed against pollution?
_____ yes, no.

CODED

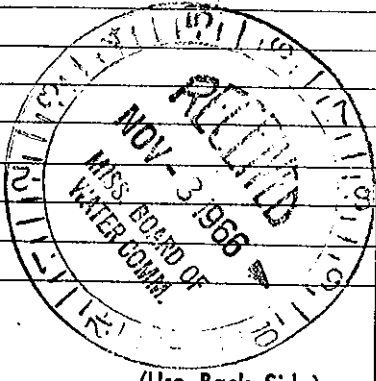

(Use Back Side)

Well No.

Retain this copy for your office files.