

CARROLL MISSISSIPPI BOARD OF WATER COMMISSIONERS

~~3~~ 3
9-20-60

WATER WELL DRILLER **CODED**

~~3~~ 03
Carroll

Date: SEPT. 20, 1960, Driller: DELTA DRILLING Co County: LEFLORE


(Name)

(1) Owner of Land: <u>C.A. MILLER, JR.</u> (Name)	Description & Color of Materials Sand, Clay, Red Clay, Shell, etc.	Thick- ness Feet	Depth Feet
<u>GREENWOOD, MISS.</u> (Address)	<u>RED CLAY</u>	<u>95</u>	<u>95</u>
(2) Location: <u>1/4</u> , <u>1/4</u> , Sec. <u>5</u>	<u>GREEN SAND - 3' GUMBO - 148'</u>	<u>118</u>	<u>213</u>
<u>11</u> miles <u>SOUTHEAST</u> , of <u>CARROLLTON</u> (distance) (direction) (Nearest Town)	<u>SHALE</u>	<u>21</u>	<u>234</u>
(3) Topography: _____ (Hilly) (Flat) (Level)	<u>WHITE SAND</u>	<u>12</u>	<u>246</u>
(4) Purpose of Well: <u>DOMESTIC</u> (Domestic Irrigation Municipal, Industrial, Other)	<u>SHALE</u>	<u>10</u>	<u>256</u>
	<u>SAND</u>	<u>8</u>	<u>264</u>
	<u>SHALE</u>	<u>7</u>	<u>271</u>
	<u>GREEN SAND</u>	<u>32</u>	<u>303</u>
	<u>SAND STREAKED SHALE</u>	<u>13</u>	<u>346</u>
	<u>SAND</u>	<u>36</u>	<u>402</u>

Information upon completion of well:

- (1) Diameter 4 inches.
- (2) Total Depth 402 feet.
- (3) Water Level _____ feet below top of ground.
- (4) Cased to 402', Size 4" - 200', 2" - 182'
- (5) Screen: Size 2, Length 20'
- (6) Were any formations sealed against pollution?
_____ yes, _____ no.

CODED

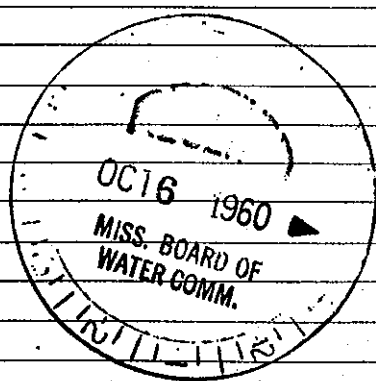

Drillers Remarks: 3/4 H.P. RED JACKET PUMP SET IN WELL

Well No.

(Use Back Side)

Mail this copy to Board of Water Commissioners 429 Miss. St. Jackson, Miss