

CARROLL

MISSISSIPPI BOARD OF WATER COMMISSIONERS


0-5

05
5-62

WATER WELL DRILLERS LOG

Date: May, 1962, Driller: Jack Martin County Carroll
(Name)

(1) Owner of Land: <u>L.W. Wade Planting Co</u> (Name)	Description & Color of Materials Sand, Clay, Red Clay, Shell, etc.	Thick- ness Feet	Depth Feet
<u>Greenwood</u> (Address)	Top Clay	4	4
(2) Location: <u>NE 1/4, SW 1/4, Sec. 25 T2R5E</u>	Sand	4	8
<u>1 1/2</u> miles <u>South</u> of <u>Waidea</u> (distance) (direction) (Nearest Town)	Pipe Clay	7	15
(3) Topography: <u>Hilly</u> (Hilly) (Flat) (Level)	Mud - little sand	29	44
(4) Purpose of Well: <u>Domestic</u> (Domestic Irrigation Municipal, Industrial, Other)	Mud	Elev: 30	74
Information upon completion of well:	Mud - Sand streaks	16	90
(1) Diameter <u>4" x 2</u> inches.	Mud	18	108
(2) Total Depth <u>320</u> feet.	Mud - Sand Streaks	20	128
(3) Water Level <u>48</u> feet below top of ground.	Sand	3	131
(4) Cased to <u>300</u> , Size <u>4" x 2"</u>	Shale - Sand Str.	13	144
(5) Screen: Size <u>2"</u> , Length <u>20 ft.</u>	Mud - rock layers	43	187
(6) Were any formations sealed against pollution? _____ yes, _____ no.	Shale - little sand	12	200
If YES depth of formation _____	Mud	3	203
Why _____	rock	12	215
Drillers Remarks: <u>168 ft 4" at top balance 2"</u>	mud - little sand	15	230
_____	<u>CODED</u>	63	293
_____	<u>CODED</u>		

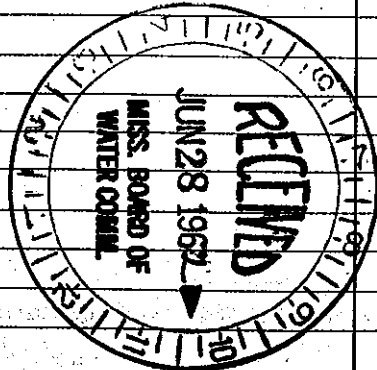

(Use Back Side)

Well No.

Mail this copy to Board of Water Commissioners 429 Miss. St. Jackson, Miss