

CODED

E 107 #38

Carroll

013

8-22-68

U.S.G.S

MISSISSIPPI
BOARD OF WATER COMMISSIONERS
416 North State Street
Jackson, Mississippi 39201

WATER WELL DRILLERS LOG

AUG 22 1968

DELTA DRILLING CO.

CARROLL

date well completed

firm name

county well located

LANDOWNER: D.F. SHORT
GREENWOOD, MISS
SHORT TRUCK STOP
VAIDEN, MISS

(mailing address)

description of formations encountered

from to

CLAY	0	60
Shale w/ROCK	60	97
CLAY w/ROCKS -	97	110
SAND w/ROCKS -	110	129
GREEN SAND	129	155
Shale	155	161
GREEN SAND w/ROCK	161	194
Shale	194	215
Sand	215	235
Shale	235	250
Sand	250	257
Shale	257	267
Sand	267	289
Shale	289	332
Sand	332	340
Shale	340	366
Sand	366	390
SHALE	390	415

WELL LOCATION: SW4-NW4 SE4

sec. 16 T17 N R. 5 E

INTERSTATE 55+35
INTERSECTION of VAIDEN


(distance) (direction) (nearest town)

WELL PURPOSE: MUNICIPAL
(home, irrigation, municipal, industrial)

WELL COMPLETION DATA:

- (1) diameter (inches) 4"
- (2) total depth (feet) 415
- (3) static water level (feet) 103 below top of ground.
- (4) casing STEEL 370' (material) (depth)
4 1/2" (size) if telescope see back.
- (5) screen 20' 370 (length) (depth to top)
2" S. STEEL (size) (material)
- (6) pump 1 1/2 32 (HP) (yield gpm)
ELEC (type power)
- (7) electric log YES (yes or no)
U.S.G.S. (organization running log)
- (8) how well bottom plugged BACK PRESSURE VALVE

CODED

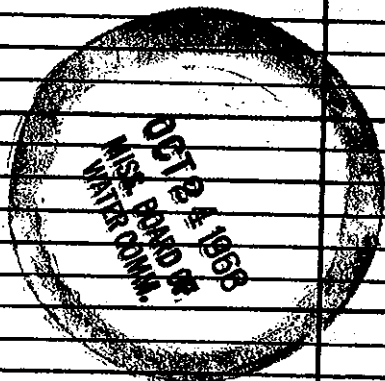

DRILLERS REMARKS: PUMP SETTING 147'