

CARROLL MISSISSIPPI BOARD OF WATER COMMISSIONERS


030
12-64

WATER WELL DRILLERS LOG

CODED

Date: Dec, 1964, Driller: Jack Martin County Holmes
(Name)

(1) Owner of Land: <u>E. W. McLellan</u> (Name)	Description & Color of Materials Sand, Clay, Red Clay, Shell, etc.	Thick- ness Feet	Depth Feet
<u>Warden</u> (Address)	Clay	8	8
(2) Location: <u>SW 1/4, NE 1/4, Sec. 26 T17R5E</u>	Sand - pipe clay	18	26
<u>1</u> miles <u>S.</u> of <u>Warden</u> (distance) (direction) (Nearest Town)	Sand - mud	44	70
(3) Topography: <u>Hilly</u> (Hilly) (Flat) (Level)	Blue mud	12	82
(4) Purpose of Well: <u>Domestic</u> (Domestic Irrigation Municipal, Industrial, Other)	Fine sand - mud	33	115
Information upon completion of well:	Mud	43	158
(1) Diameter <u>4 1/2"</u> inches.	Sand	44	202
(2) Total Depth <u>325</u> feet.	Mud - sand streak	20	222
(3) Water Level <u>60</u> feet below top of ground.	Rock	3	225
(4) Cased to <u>310</u> , Size <u>4 1/2"</u>	Sand	4	229
(5) Screen: Size <u>2"</u> , Length <u>15</u>	Rock CODED	14	243
(6) Were any formations sealed against pollution? _____ yes, _____ no.	Sand	5	248
If YES depth of formation _____	Shale rock layers	37	285
Why _____	Sand	40	325
Drillers Remarks: _____			

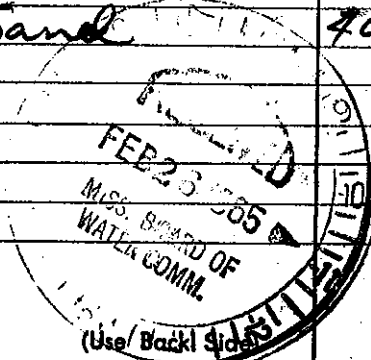

Well No.

Mail this copy to Board of Water Commissioners 429 Miss. St. Jackson, Miss