

Carroll

0 31 MISSISSIPPI BOARD OF WATER COMMISSIONERS

1-67

CODED

WATER WELL DRILLERS LOG

Date: 1-24, 1967, Driller: Smith Forge Welding County, Carroll

(When well drilled)

(Name)

(Where well is located)

(1) Owner of Land: Delma Miller
(Name)
R I Vaidan Miss
(Address)
(2) Location: E. 2 1/4 NE 4 1/4, Sec. 7 T17R
SE
4 miles NW of Vaidan
(distance) (direction) (Nearest Town)
(3) Topography: flat
(Hilly) (Flat) (Level)
(4) Purpose of Well: Domestic
(Domestic Irrigation
Municipal, Industrial, Other)

Description & Color of Materials Sand, Clay, Red Clay, Shell, etc.	Thick- ness Feet	Depth Feet
red clay	14	14
red sand	4	18
white clay	2.0	38
white clay		
sand mixture	12	50
white sand	25	75
black sand		
black clay mixture	5	80
black clay	10	90
thin rock		
black clay	38	128
black and blue		
mixture clay	12	140
black clay black		
sand mixture	20	160
series of thin rock	10	170
blue clay sand mixture	10	180
blue sand	10	190
light blue sand	40	230
black clay	2	232
black clay sand	32	264
Mixture		
gray sand	30	294
blue clay sand mixture	6	300
light gray sand	14	314

Information upon completion of well:

(1) Diameter 2 inches.

(2) Total Depth 314 feet.

(3) Water Level 80 feet below top of ground.

(4) Cased to 308, Size 2 X 1 1/4.

(5) Screen: Size 1 1/4, Length 6'.

(6) Were any formations sealed against pollution?
 _____ yes, X no.

If YES depth of formation _____


Why _____

Drillers Remarks: _____

Yield in gpm: _____

Size pump: _____

Type power: _____

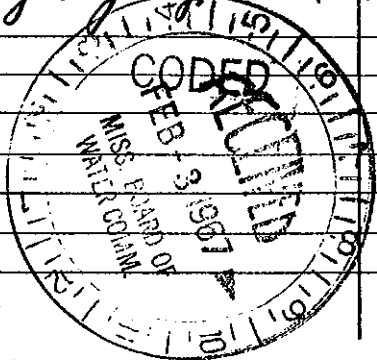

26

Mail this copy to Board of Water Commissioners 429 Miss. St. Jackson, Miss.