

Carroll  
032  
7-67

MISSISSIPPI  
BOARD OF WATER COMMISSIONERS  
416 North State Street  
Jackson, Mississippi 39201

INDEXED

WATER WELL DRILLERS LOG

7-25-1967 date well completed  
Smith For Bee Welding firm name  
Carroll county well located

LANDOWNER: Willie Hooper  
R1 Box 175  
Varden miss  
(mailing address)


WELL LOCATION:  
sec. 21 T. 17 N R. 5 E  
S 8 1/2 S 58 1/2 W  
3 1/2 miles SW of Varden  
(distance) (direction) (nearest town)

WELL PURPOSE: HOME  
(home, irrigation, municipal, industrial)

WELL COMPLETION DATA:

- (1) diameter (inches) 2
- (2) total depth (feet) 245
- (3) static water level (feet) 105 below top of ground.
- (4) casing 2" galv. 220 ft + 6" (material) (depth)  
2 1/4" (size) If telescope see back.
- (5) screen 6' 245' (length) (depth to top)  
80 Brass (size) (material)
- (6) pump 1/2 HP Red about 250 gpm (HP) (yield gpm)  
Electricity (type power)
- (7) electric log NO (yes or no)
- (organization running log)
- (8) how well bottom plugged

description of formations encountered	from	to
Red Clay	0	18
red sand	22	40
white sand	8	48
sand rock about	1	42
white sand		
white clay mixture	5	54
Black Clay	41	95
white rock about	1	96
thin layers of rock	10	106
blue clay		
sand mixture	9	115
rock about	1	116
sand blue clay mixture	20	136
gray sand	6	142
gray sand black clay mixture	144	186
gray sand	7	194
black clay	6	200
gray sand black clay mixture	20	220
at good grade of white sand	95	245

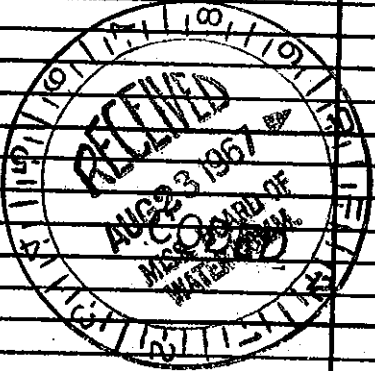

DRILLERS REMARKS: