

CARROLL


MISSISSIPPI BOARD OF WATER COMMISSIONERS

P/6
7-66

WATER WELL DRILLERS LOG

Date: July, 1966, Driller: Jack Martin County Carroll
Helena
(Name)

| (1) Owner of Land: <u>John Wallace</u> (Name) | Description & Color of Materials Sand, Clay, Red Clay, Shell, etc. | Thick- ness Feet | Depth Feet |
|---|---|------------------------|---------------|
| <u>Waiden</u> RT #1 (Address) | <u>clay</u> | <u>12</u> | <u>12</u> |
| (2) Location: <u>NW 1/4, NE 1/4, Sec. 34 T17R6E</u> <u>4 1/2</u> miles <u>SE</u> of <u>Waiden</u> (distance) (direction) (Nearest Town) | <u>sand rock</u> | <u>4</u> | <u>16</u> |
| (3) Topography: <u>Hilly</u> (Hilly) (Flat) (Level) | <u>Sand</u> | <u>119</u> | <u>135</u> |
| (4) Purpose of Well: <u>Domestic</u> (Domestic Irrigation Municipal, Industrial, Other) | CODED | | |
| Information upon completion of well: | | | |
| (1) Diameter <u>2</u> inches. | | | |
| (2) Total Depth <u>135</u> feet. | | | |
| (3) Water Level <u>102</u> feet below top of ground. | CODED | | |
| (4) Cased to <u>130</u> , Size <u>2"</u> | | | |
| (5) Screen: Size <u>2"</u> , Length <u>5'</u> | | | |
| (6) Were any formations sealed against pollution? <u>no</u> | | | |
| If YES depth of formation _____ | | | |
| Why _____ | | | |
| Drillers Remarks: _____ | | | |
| _____ | | | |
| _____ | | | |

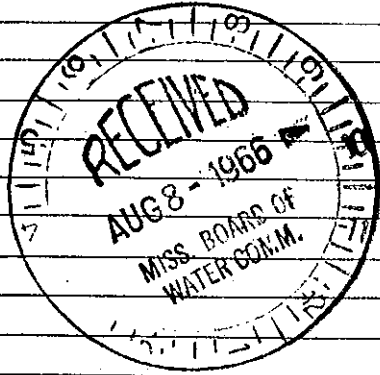

Well No.

(Use Back Side)

Mail this copy to Board of Water Commissioners 429 Miss. St. Jackson, Miss.