

CARROLL MISSISSIPPI BOARD OF WATER COMMISSIONERS

Q1
6-30-61

WATER WELL DRILLERS LOG

7/19/61
Jm

Date: June 30, 1961, Driller: Layne-Central Company, County Carroll

(Name)

(1) Owner of Land:	Description & Color of Materials Sand, Clay, Red Clay, Shell, etc.	Thick- ness Feet	Depth Feet
L. W. Wade Planting Co. (Name)	Sandy red clay	25	25
Greenwood, Mississippi (Address)	White sand	31	6
(2) Location: 1/4, 1/4, Sec. T R	Hard shale	52	21
3 miles south of Vaiden (distance) (direction) (Nearest Town)	Brittle shale & sand	72	20
(3) Topography: flat (Hilly) (Flat) (Level)	Sand, strks. shale & lignite	136	64
(4) Purpose of Well: irrigation (Domestic Irrigation Municipal, Industrial, Other)	Gummy sandy shale	142	6
	Hard shale	175	33
	White sand, blue clay balls	209	34


Information upon completion of well:

- (1) Diameter 12 x 8 inches.
- (2) Total Depth 332 feet.
- (3) Water Level 2' 1" feet below top of ground.
- (4) Cased to 83', Size 12" 15 1/4' 8"
- (5) Screen: Size 95', Length 8"
- (6) Were any formations sealed against pollution?
yes, X no.

If YES depth of formation _____

Why _____

Drillers Remarks: _____

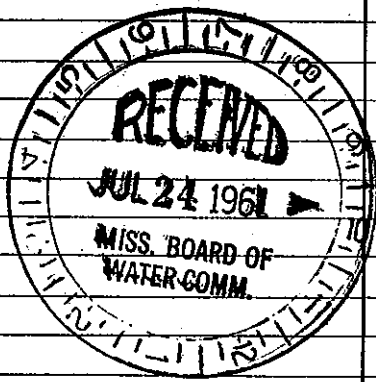

(Use Back Side)

Well No.

Mail this copy to Board of Water Commissioners 429 Miss. St. Jackson, Miss.