


CARROLL
Q 9
5-62

MISSISSIPPI BOARD OF WATER COMMISSIONERS

WATER WELL DRILLERS LOG

Date: May, 1962, Driller: Jack Martin County: Carroll
(Name)

(1) Owner of Land:	Description & Color of Materials Sand, Clay, Red Clay, Shell, etc.	Thick- ness Feet	Depth Feet
<u>Mrs Lynn Gordin</u> (Name) <u>Vaiden</u> (Address)	<u>Top clay</u>	<u>12</u>	<u>12</u>
	<u>Red sand</u>	<u>9</u>	<u>21</u>
(2) Location: <u>NW 1/4, NW 1/4, Sec. 5 T16R5E</u>	<u>White sand</u>	<u>74</u>	<u>95</u>
<u>8</u> miles <u>SW</u> , of <u>Vaiden</u> (distance) (direction) (Nearest Town)	<u>Pipe clay</u>	<u>23</u>	<u>118</u>
(3) Topography: <u>Hilly</u> (Hilly) (Flat) (Level)	<u>Sand</u>	<u>10</u>	<u>128</u>
(4) Purpose of Well: <u>Domestic</u> (Domestic Irrigation Municipal, Industrial, Other)	<u>Pipe clay</u>	<u>20</u>	<u>148</u>
	<u>Sand - little mud</u>	<u>16</u>	<u>164</u>
	<u>Mud - Rock layers</u> (Rock at 174 - 189) <u>- 195 - 215</u>	<u>96</u>	<u>260</u>
Information upon completion of well:	<u>Mud - Sand</u>	<u>30</u>	<u>290</u>
(1) Diameter <u>2</u> inches.	<u>Sand</u>	<u>45</u>	<u>335</u>
(2) Total Depth <u>334</u> feet.	<u>CODED</u>		
(3) Water Level _____ feet below top of ground.			
(4) Cased to <u>324</u> , Size <u>2</u>			
(5) Screen: Size <u>2"</u> , Length <u>10'</u>	<u>CODED</u>		
(6) Were any formations sealed against pollution? _____ yes, _____ no.			
If YES depth of formation _____			
Why _____			
Drillers Remarks: _____			

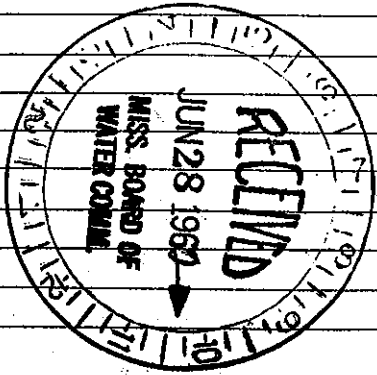

(Use Back Side)

Well No.

Mail this copy to Board of Water Commissioners 429 Miss. St. Jackson, Mi/