

CARROLL MISSISSIPPI BOARD OF WATER COMMISSIONERS

Q 11
3-29-66

WATER WELL DRILLERS LOG

Date: 3-29, 1966, Driller: Smith Jorg & Welling, county Carroll
(Name)

(1) Owner of Land: Curtis King
(Name)
Rt 1 Box 3A Vaiden
(Address)

(2) Location: SE 1/4, NW 1/4, Sec. 4 T16R5E
6 miles SW of Vaiden
(distance) (direction) (Nearest Town)

(3) Topography: Hilly
(Hilly) (Flat) (Level)

(4) Purpose of Well: Domestic
(Domestic Irrigation
Municipal, Industrial, Other)

Description & Color of Materials Sand, Clay, Red Clay, Shell, etc.	Thick- ness Feet	Depth Feet
red clay	12	12
tan rock	6"	
red sand	30	42
white clay	11	53
black clay	61	114
a series of hard rock in and out	10	124
gray sand black clay mixture	11	135
hard rock about 11"		136
green sand with light green sand a very good grade	30	166
	24	190

Information upon completion of well:

(1) Diameter 2 inches.

(2) Total Depth 190 feet.

(3) Water Level 80 feet below top of ground.

(4) Cased to 184, Size 2

(5) Screen: Size 1 1/4, Length 6'


(6) Were any formations sealed against pollution?
_____ yes, X no.

If YES depth of formation _____

Why _____

Drillers Remarks: _____

CODED

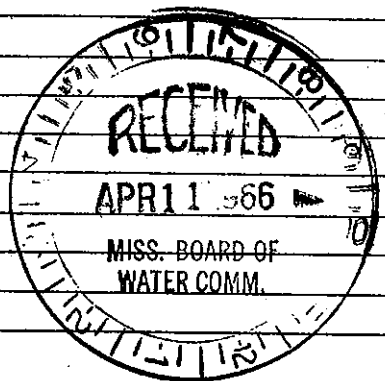

(Use Back Side)

Well No.

Mail this copy to Board of Water Commissioners 429 Miss. St. Jackson, Miss.