

Carroll  
 Q 13  
 8-10-68

MISSISSIPPI  
 BOARD OF WATER COMMISSIONERS  
 416 North State Street  
 Jackson, Mississippi 39201

WATER WELL DRILLERS LOG

8-10-1968 date well completed  
 SMITH FOR GEORGE CARROLL firm name  
 Carroll county well located

LANDOWNER: Rachael King  
 RFR  
 Vaidian miss  
 (mailing address)


WELL LOCATION:  
 sec. 4 T-16 N R-5 E  
 S W  
 7 miles S of Vaidian  
 (distance) (direction) (nearest town)

WELL PURPOSE: HOME  
 (home, irrigation, municipal, industrial)

WELL COMPLETION DATA:

- (1) diameter (inches) 2"
- (2) total depth (feet) 220
- (3) static water level (feet) 65 below top of ground.
- (4) casing galv. (material) (depth) 2' if telescope see back.
- (5) screen 6" (length) (depth to top) 1 1/4" copper gauge (size) (material)
- (6) pump 1/4 (HP) about 280 (yield gpm) PH Electricity (type power)
- (7) electric log X NO (yes or no)  
 (organization running log)
- (8) how well bottom plugged

description of formations encountered	from	to
Red clay	0	14
White clay	14	23
White clay sand mixture	23	43
White sand	43	55
rock COPIED	55	56
Black clay	56	61
blue clay	61	101
white rock	101	104
series of thin rock	104	119
gray sand		
blue clay mix.	119	159
gray clay	159	176
gray sand	176	186
gray clay sand mixture	186	195
good grade of gray sand	195	220

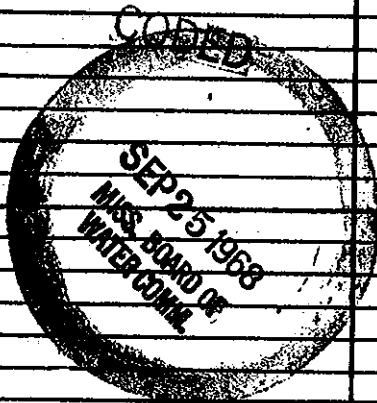

DRILLERS REMARKS: