

Chickasaw

A 15

3 150

6-67

MISSISSIPPI BOARD OF WATER COMMISSIONERS

CODED

CODED

CODED

WATER WELL DRILLERS LOG

Hendon-Homan Well & Supply, Inc.

Date: 6-30, 1967, Driller: P. O. Box 42, County Chickasaw, MISSISSIPPI

1) Owner of Land	Description & Color of Materials	Thick-ness Feet	Depth Feet
Gravelle Lumber Co. (Name)	uniform sand & clay	0	35
CONTRACTOR, Tupelo, Miss (Address)	blue clay	35	220
2) Location: NE 1/4, SE 1/4, Sec. 15, T12R2E	sand	220	340
2 1/2 miles West of Houma (distance, direction, Nearest Town)	bottom	340	
3) Topography: flat (Hilly, Flat, Level)			
4) Purpose of Well: Home (Domestic Irrigation, Municipal, Industrial, Other)			

Information upon completion of well:

1) Diameter 4 inches.

2) Total Depth 340 feet.

3) Water Level 70 feet below top of ground.

4) Cased to 39' 8", Size 4"

5) Screen: Size none Length

6) Were any formations sealed against pollution?
 yes, no.

f YES depth of formation 35'


Why uniform sand

Drillers Remarks:

Yield in gpm: 3

Size pump: 3/4 HP 5ft

Type power: electric

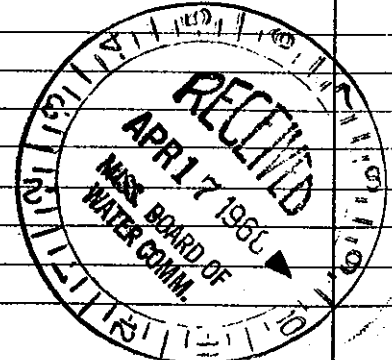

mail this copy to Board of Water Commissioners 429 Miss. St. Jackson, Miss.