


CHICKASAW MISSISSIPPI BOARD OF WATER COMMISSIONERS

A 2000
11-65

WATER WELL DRILLERS LOG

Date: November, 19 65, Driller: Johnny Webb County Chickasaw
(Name)

(1) Owner of Land:	Description & Color of Materials Sand, Clay, Red Clay, Shell, etc.	Thick- ness Feet	Depth Feet
<u>Loy Walker</u> (Name) <u>Houlka, Mississippi</u> (Address)	<u>Clay sand to 12'</u>		
(2) Location: <u>1/4, 1/4, Sec. T12R2</u>	<u>Blue mud 12-20'</u>		
<u>3</u> miles <u>N-W</u> of <u>Houlka</u> (distance) (direction) (Nearest Town)	<u>Water sand 20-150'</u>		
(3) Topography: <u>X</u> (Hilly) (Flat) (Level)			
(4) Purpose of Well: <u>Domestic</u> (Domestic Irrigation Municipal, Industrial, Other)			
Information upon completion of well:			
(1) Diameter <u>4</u> inches.	<p>CANNOT Locate</p> <p>JES</p>		
(2) Total Depth <u>150</u> feet.			
(3) Water Level <u>30</u> feet below top of ground.			
(4) Cased to <u>21'</u> , Size <u>4"</u>			
(5) Screen: Size _____, Length _____			
(6) Were any formations sealed against pollution? _____ yes, _____ no.			
If YES depth of formation _____			
Why _____			
Drillers Remarks: _____			

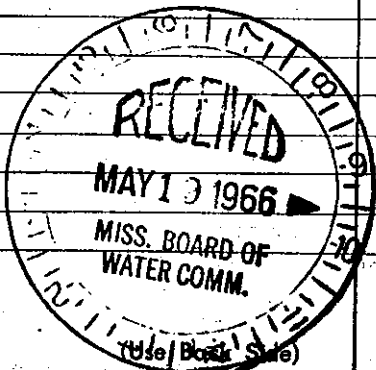

Well No

Mail this copy to Board of Water Commissioners 429 Miss. St. Jackson, Miss.