

CHICKASAW MISSISSIPPI BOARD OF WATER COMMISSIONERS

B 26 3 13E

CODED

11-63

WATER WELL DRILLERS LOG

CODED


Date: Nov. 19, 1963, Driller: Merndon-Homan Well & Supply Co. County: Chickasaw

P. O. BOX 42
 SHANNON, MISSISSIPPI 38868

(1) Owner of Land:	Description & Color of Materials	Thick-ness Feet	Depth Feet
<u>T.A. Duke</u> (Name)	<u>surface sand</u>		
<u>Houlka, Miss</u> (Address)	<u>& clay</u>	<u>0</u>	<u>175</u>
(2) Location: <u>SE 1/4, SE 1/4, Sec. 3 T. 12 S. R. 3 E</u>	<u>Blue clay</u>	<u>175</u>	<u>650</u>
<u>3</u> miles <u>E</u> of <u>Houlka</u> (distance) (direction) (Nearest Town)	<u>sand</u>	<u>650</u>	<u>800</u>
(3) Topography: <u>Hilly</u> (Hilly) (Flat) (Level)	<u>Bottom</u>	<u>800</u>	
(4) Purpose of Well: <u>Domestic</u> (Domestic Irrigation Municipal, Industrial, Other)			

Information upon completion of well:

- (1) Diameter 4 inches.
- (2) Total Depth 800 feet.
- (3) Water Level 180 feet below top of ground.
- (4) Cased to 182', Size 4"
Bottom 399', Size 2"
- (5) Screen: Size 2", Length —
- (6) Were any formations sealed against pollution?
 yes, no.
- If YES depth of formation 175'
- Why surface & sand
- Drillers Remarks:

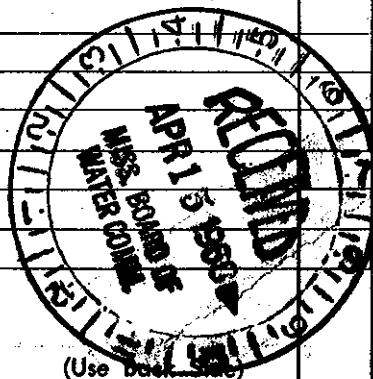

Well No.

Mail this copy to Board of Water Commissioners 429 Miss. St. Jackson, Miss.