

CHICKASAW MISSISSIPPI BOARD OF WATER COMMISSIONERS


C 18 5 13E

4-19-63

WATER WELL DRILLERS LOG

Date April 19, 1963, Driller: HERNDON WELL & SUPPLY CO
 P.O. BOX 42 County Chickasaw
 SEAINSON MISSISSIPPI

(1) Owner of Land: <u>James Duke</u> (Name)	Description & Color of Materials Sand, Clay, Red Clay, Shell, etc.	Thick- ness Feet	Depth Feet
<u>Okolona, Miss</u> (Address)	<u>surface sand</u>		<u>0</u>
(2) Location: <u>1/4, 1/4, Sec 27 T 125 R 4E</u> <u>2</u> miles <u>E</u> of <u>Van Vleet</u> (distance) (direction) (Nearest Town)	<u>to</u> <u>blue rock</u>		<u>28</u>
(3) Topography: <u>Flat</u> (Hilly) (Flat) (Level)	<u>to</u> <u>sand</u>		<u>530</u>
(4) Purpose of Well: <u>Domestic</u> (Domestic Irrigation Municipal, Industrial, Other)	<u>to</u> <u>Bottom</u>		<u>660</u>
Information upon completion of well:			
(1) Diameter <u>5</u> inches.			
(2) Total Depth <u>660</u> feet.			
(3) Water Level <u>140</u> feet below top of ground.			
(4) Cased to <u>32 1/2"</u> , Size <u>5"</u>			
(5) Screen: Size _____, Length _____			
(6) Were any formations sealed against pollution?			
<input checked="" type="checkbox"/> yes, _____ no.			
YES depth of formation <u>26'</u>			
Why <u>surface & sand</u>			
Drillers Remarks:			

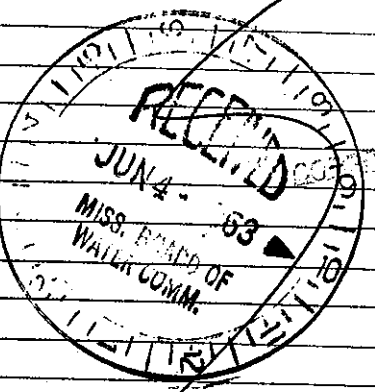

Well No.

(Use Back Side)

Mail this copy to Board of Water Commissioners 429 Miss. St. Jackson, Miss