

CHICKASAW

MISSISSIPPI BOARD OF WATER COMMISSIONERS

D29

5 13L

11-7-62

WATER WELL DRILLERS LOG

CODED

CODED

Date: Apr 7, 1962, Driller: HERNDON WELL & SUPPLY Co. Chickasaw

P. O. Box 42
SHANNON, MISSISSIPPI

| (1) Owner of Land: <u>E. F. Davis</u> (Name) | Description & Color of Materials Sand, Clay, Red Clay, Shell, etc. | Thick- ness Feet | Depth Feet |
|---|---|------------------------|---------------|
| <u>Okolona, Miss</u> (Address) | <u>sand & clay</u> | | <u>0</u> |
| (2) Location: <u>33 12 30</u> Sec. <u>33</u> T. <u>12</u> R. <u>30</u> | <u>Blue sand</u> | | <u>20</u> |
| <u>2 1/2</u> miles <u>W</u> , of <u>Okolona</u> (distance) (direction) (Nearest Town) | <u>sand</u> | | <u>400</u> |
| (3) Topography: <u>Flat</u> (Hilly) (Flat) (Level) | <u>Bottom</u> | | <u>580</u> |
| (4) Purpose of Well: <u>Domestic</u> (Domestic Irrigation Municipal, Industrial, Other) | | | |


Information upon completion of well:

- (1) Diameter 4 inches.
- (2) Total Depth 580 feet.
- (3) Water Level 175 feet below top of ground.
- (4) Cased to 302', Size 4",
290', Size 2"
- (5) Screen: Size 2", Length 40'
- (6) Were any formations sealed against pollution?
 yes, no.

If YES depth of formation 20

Why surface sand

Drillers Remarks:

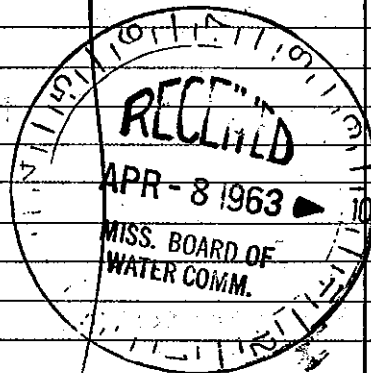

(Use Back Side)

Well No.

Mail this copy to Board of Water Commissioners 429 Miss. St. Jackson, Miss.