

CHICKASAW MISSISSIPPI BOARD OF WATER COMMISSIONERS

D30 5 13C

10-25-63 WATER WELL DRILLERS LOG

CODED

Date: Oct. 25, 1963, Driller: Herndon-Homan Well & Supply, Inc.
 P. O. Box 42 County Chickasaw
 SHANNON, MISSISSIPPI 38868

| (1) Owner of Land: | Description & Color of Materials | Thick-ness Feet | Depth Feet |
|---|----------------------------------|-----------------|----------------|
| <u>Mike West</u> (Name) | <u>clay</u> | | <u>0-23</u> |
| <u>Okolona, Miss</u> (Address) | <u>blue clay</u> | | <u>23-360</u> |
| (2) Location: $\frac{1}{4}$, $\frac{1}{4}$, Sec. <u>3 T. 12 S. R. 2 E</u> | <u>Sand</u> | | <u>360-480</u> |
| <u>4</u> miles <u>NW</u> , of <u>Okolona</u> (distance) (direction) (Nearest Town) | <u>Bottom</u> | | <u>480</u> |
| (3) Topography: <u>Flat</u> (Hilly) (Flat) (Level) | | | |
| (4) Purpose of Well: <u>Domestic</u> (Domestic Irrigation, Municipal, Industrial, Other) | | | |

Information upon completion of well:

(1) Diameter 5 inches.

(2) Total Depth 460 feet.

(3) Water Level 60 feet below top of ground.

(4) Cased to 26', Size 5"


(5) Screen: Size _____, Length _____

(6) Were any formations sealed against pollution?
 yes, _____ no.

If YES depth of formation 23'

Why surface & sand

Drillers Remarks:

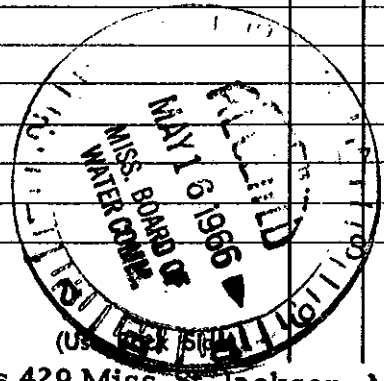

Well No.

Mail this copy to Board of Water Commissioners 429 Miss. St. Jackson, Miss.