

Chickasaw

D 31

3 13C

3-66

MISSISSIPPI BOARD OF WATER COMMISSIONERS

CODED

### WATER WELL DRILLERS LOG

Date: March 19 66, Driller: Herndon-Homan Well & Supply, Inc.  
 (When well drilled) P. O. Box 42 County Chickasaw  
SHANNON MISSISSIPPI 38860 (where well is located)

(1) Owner of Land: John Young  
 (Name)  
Okolona Miss.  
 (Address)

(2) Location: NE 1/4, NW 1/4, Sec 20 T12R5  
4 miles NW, of Okolona  
 (distance) (direction) (Nearest Town)

(3) Topography: Flat  
 (Hilly) (Flat) (Level)

(4) Purpose of Well: Home  
 (Domestic Irrigation  
 Municipal, Industrial, Other)

Description & Color of Materials Sand, Clay, Red Clay, Shell, etc.	Thick- ness Feet	Depth Feet
<u>surface mud &amp; clay</u>	<u>20</u>	<u>20</u>
<u>blue clay</u>	<u>460</u>	<u>500</u>
<u>Sand</u>	<u>120</u>	<u>620</u>
<u>Bottom</u>		<u>620</u>

#### Information upon completion of well:

(1) Diameter 5 inches.

(2) Total Depth 620 feet.

(3) Water Level 160 feet below top of ground.

(4) Cased to 22', Size 5"

(5) Screen: Size NONE, Length \_\_\_\_\_

(6) Were any formations sealed against pollution?  
 yes, \_\_\_\_\_ no.

If YES depth of formation 20'


Why surface & sand

Drillers Remarks: \_\_\_\_\_

Yield in gpm: 6

Size pump: 3/4 HP

Type power: electric

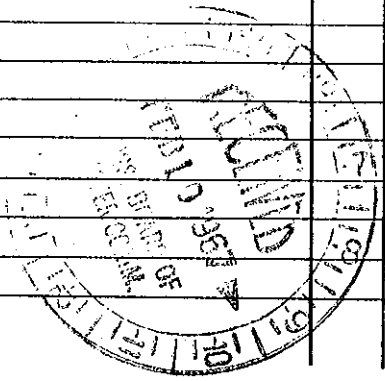

Mail this copy to Board of Water Commissioners 429 Miss. St. Jackson, Miss.