

3 13L

CODED

Chickasaw

D35

2-67

MISSISSIPPI  
BOARD OF WATER COMMISSIONERS  
416 North State Street  
Jackson, Mississippi 39201

CODED

WATER WELL DRILLERS LOG

Herndon-Homan Well & Supply, Inc.

P. O. Box 42

SHANNON, MISSISSIPPI 38868

Chickasaw  
county well located

2-28 1967  
date well completed


LANDOWNER:  
Bobby Anderson  
Okolona, Mississippi  
(mailing address)

description of formations encountered	from	to
Sandstone sand & clay	0	30
Blue clay	30	400
Sand	400	560
Bottom	560	

WELL LOCATION:  
sec 27 T 12 N R 5 E  
S W  
1 miles N.W. of Okolona  
(distance) (direction) (nearest town)

WELL PURPOSE: Home  
(home, irrigation, municipal, industrial)

- WELL COMPLETION DATA:
- (1) diameter (inches) 5"
  - (2) total depth (feet) 560'
  - (3) static water level (feet) 148' below top of ground.
  - (4) casing steel 32' (material) (depth)  
5" (size) If telescope see back.
  - (5) screen none (length) (depth to top)  
(size) (material)
  - (6) pump 3/4 (HP) 10 (yield gpm)  
electric (type power)
  - (7) electric log no (yes or no)  
(organization running log)
  - (8) how well bottom plugged open

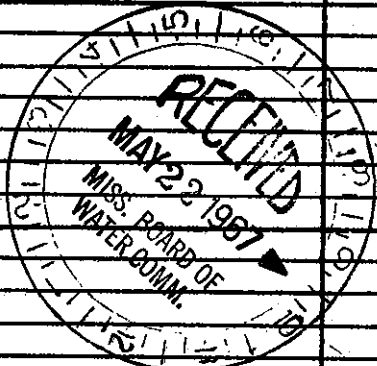

DRILLERS REMARKS: