

130 3

Chick ASAW
D 36
7-67

MISSISSIPPI
BOARD OF WATER COMMISSIONERS
416 North State Street
Jackson, Mississippi 39201

CODED

WATER WELL DRILLERS LOG

7/20/67 Harndon-Homan Well & Supply, Chick ASAW
date well completed firm name Box 42 county well located
SHANNON, MISSISSIPPI 38868


LANDOWNER:
Floyd Williams
Okolona, Miss
(mailing address)

description of formations encountered	from	to
surface sand & clay	0	18
blue clay	18	380
summit	380	500
380 ft	500	

WELL LOCATION:
sec. 25 T-14 N R-5 E
S W
1/2 miles NE of Okolona
(distance) (direction) (nearest town)

WELL PURPOSE: Home
(home, irrigation, municipal, industrial)

- WELL COMPLETION DATA:
- (1) diameter (inches) 5"
 - (2) total depth (feet) 500'
 - (3) static water level (feet) 140' below top of ground
 - (4) casing steel, 21 7/8" (material) (depth)
 - (5) screen none (length) (depth to top)
 - (6) pump 3/4 HP, 10 (yield gpm)
electric (type power)
 - (7) electric log NO (yes or no)
 - (8) how well bottom plugged open

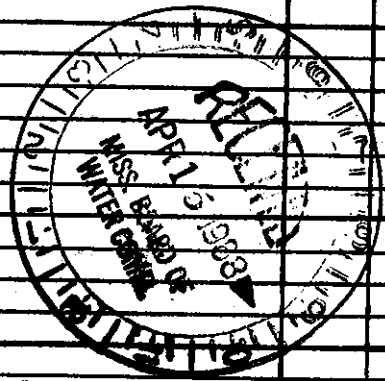

DRILLERS REMARKS: