

CHICKASAW  
D 38 3 13C  
8-67

MISSISSIPPI BOARD OF WATER COMMISSIONERS

CODED

**WATER WELL DRILLERS LOG**

Date: 8-5, 1967, Driller: Herndon-Homan Well & Supply, Inc. County: Chickasaw  
(When well drilled) P. O. Box 42 Where well is located  
SHANNON, MISSISSIPPI 38868

(1) Owner of Land: Leoy Sellers  
(Name)  
pt 1 Shannon, Miss.  
(Address)  
 (2) Location: NW 1/4, NW 1/4, Sec. 1 T12 R5E  
4 miles N of Medora  
(distance) (direction) (Nearest Town)  
 (3) Topography: flat  
(Hilly) (Flat) (Level)  
 (4) Purpose of Well: Home  
(Domestic Irrigation Municipal, Industrial, Other)

Description & Color of Materials Sand, Clay, Red Clay, Shell, etc.	Thick- ness Feet	Depth Feet
<u>surface sand &amp; clay</u>		<u>0 - 1.5</u>
<u>blue clay</u>		<u>1.5 - 3.20</u>
<u>sand</u>		<u>3.20 - 4.40</u>
<u>bottom</u>		<u>4.40</u>

Information upon completion of well:

(1) Diameter 5 inches.

(2) Total Depth 440 feet.

(3) Water Level 110 feet below top of ground.

(4) Cased to 19' 10", Size 5"

(5) Screen: Size NONE, Length \_\_\_\_\_

(6) Were any formations sealed against pollution?  
 yes,  no.

If YES depth of formation 15'


Why surface & sand

Drillers Remarks: \_\_\_\_\_

Yield in gpm: 5

Size pump: 1/2 HP Sub

Type power: electric

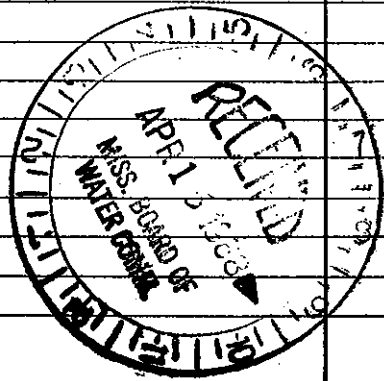

Mail this copy to Board of Water Commissioners 429 Miss. St. Jackson, Miss.