

CHICKASAW

D 39

3 13E

9-67

MISSISSIPPI BOARD OF WATER COMMISSIONERS

WATER WELL DRILLERS LOG

CODED

Date: 9-1, 1967, Driller: Herndon-Roman Well & Supply, Inc. P. O. Box 42 County Chickasaw
(When well drilled) STANNON, MISSISSIPPI 38861 (Where well is located)

(1) Owner of Land: <u>W. D. Brasfield</u> (Name)	Description & Color of Materials Sand, Clay, Red Clay, Shell, etc.	Thick- ness Feet	Depth Feet
<u>Okolona, Miss</u> (Address)	<u>Surface clay</u>	<u>0</u>	<u>15</u>
(2) Location: <u>NE 1/4, NE 1/4, Sec 31 T. 12 S. R. 5 E</u>	<u>Blue clay</u>	<u>15</u>	<u>420</u>
<u>3</u> miles <u>W</u> , of <u>Okolona</u> (distance) (direction) (Nearest Town)	<u>Sand</u>	<u>420</u>	<u>560</u>
(3) Topography: <u>Flat</u> (Hilly) (Flat) (Level)	<u>Bottom</u>	<u>560</u>	
(4) Purpose of Well: <u>Home</u> (Domestic Irrigation Municipal, Industrial, Other)			

Information upon completion of well:

(1) Diameter 5 inches.

(2) Total Depth 560 feet.

(3) Water Level 170 feet below top of ground.

(4) Cased to 17', Size 5"

(5) Screen: Size none, Length _____

(6) Were any formations sealed against pollution?
 yes, no.

If YES depth of formation 15'


Why surface & sand

Drillers Remarks: _____

Yield in gpm: 5

Size pump: 3/4

Type power: electric

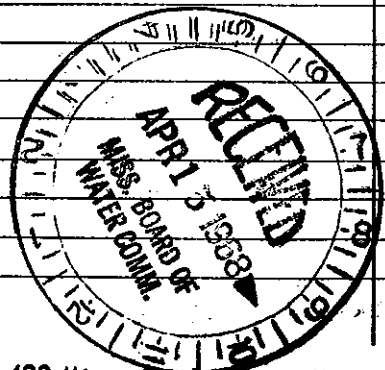

Mail this copy to Board of Water Commissioners 429 Miss. St. Jackson, Miss.