
/					
	State V	Vell Report			
County: Lickasaw		Part 1	For Office Use Only:		
Permit #: M	lississippi Departme	nt of Environmental Quality	-		
	Office of Land	and Water Resources	Aquifer:		
Driller: Leeper Drilling	P.O.	Box 10631	Well #: <u>D-/04</u>		
Date drilling completed: 6-16-08	Jackson, MS 39289-0631 (601)961-5210		L. S. Elevation:		
		54-6938 (fax)			
State Law requires that this papart			E-log #:		
State Law requires that this report 30 days of completion of drilling of	be prepared by the the	e driller in detail and filed w	th the Department within		
Well Owner Information	n		Location		
Owner Name Robbi & CArwa	than				
Mailing Address: 205 N. Buch			" Longitude:°'		
Mang Address. STOS IN. DUC	ACK CM G H-4 M Method of Lat/Long (circle one		c): Conventional Survey		
City / State Zin Code USUS quad, Hand-h		USGS quad, Hand-held	JPS, Survey-grade GPS		
			_Twn 125 Rng 56		
Telephone No. (662 447-35	47	Distance Direction	Nearest Town		
	<u> </u>	Distance Direction	f_OKoLo.14		
	Well I	Data			
Purpose of Well (circle one) Home Industri	al Public Supply	Irrigation D' L C .			
Date well drilling started:	r	Irrigation Fish Culture	Other:		
Date well drilling started: $6 - i 2 - c \delta$	Date w	vell drilling completed:	-16-08		
If flowing, method of flow regulation: Valve	Other (de	escribe)			
Static Water Level:	thelow (single)				
Method of Measurements in the	Stociow (Crecie one) la	ind surface Date measured:	6-17-08		
Method of Measurement (circle one) steel ta	pe electric tape	air line other:			
Hole depth: Well depth:	50.017	Well grouted to a day it is			
Type of grout (circle one): Cement Be		Then grouted to a depth of	feet		
			0		
Casing length: <u>40</u> feet Casing dia	meter:	_inches Type of casing:	PVC		
Screen length: <u>40</u> feet Screen dia	umeter: 2 ⁽		PVC		
Screen slot size: , Q(3) inches		_inches Type of screen:			
Screen slot size: $\circ \circ (3)$ inches Se	etting depth: From	The U feet to S	G U fect		
Type of completion (circle all applicable): Grav	vel packed Underrea	amed Telescoped Open hal			
Type of completion (circle all applicable): Gravel packed Underreamed Telescoped Open hole Natural Development Other (describe):					
Top of lan pine or reduction :	(describe):				
Top of lap pipe or reduction in casing:	feet. If teles	scoped or more than one screen	describe on back of page		
Logs run (circle all applicable): No log run Ele	ctric Gamma Ray	Density Sonic Neutron Oth	Pabo		
I certify that the well was drilled, constructed,	and completed in acc	ordance with all applicable			
		tment of Health rooms	urements of the Mississippi		
Leeper Drilling	79	or meanin regulations and	state laws.		
Leper Urilling	· /				
Print Name of Water Well Contractor and License			ser (
		Signature of Wa	ter Well Contractor		

1

Ţ

RECEIVED JUL 07 2008 BY: OLWR If well telescopes please sketch below and show depths.

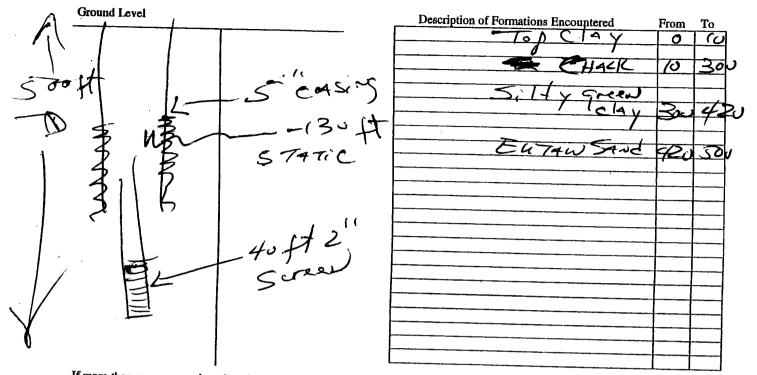

If more than one screen, show location of each on sketch

Sketch the property layout and include the following: 1) the well location; 2) any permanent structures on the property that may aid in locating the well; 3) any roads, power lines, or other items that may aid in locating the property and the well; 4) indicate direction. We out4 Arna than bie Landowner Name: Signature of Water Well Contractor

JUL 07 2008 BY: OLWR

-104

	STATE V	VELL REPORT		
County: ChickAshw Pump Installe Permit #: Mississippi Departm Driller: Leeper Drilling Production Date completed: County-org (60)		Part 2 er's Completion Report ment of Environmental Quality and and Water Resources D. Box 10631 MMS 39289-0631 01)961-5210 0354-6938 (fax)	For Office Use Only: Aquifer: Well #:	
This report should be prepared by the installation of pump.	e pump installer in de	etail and filed with the Departmen	t within 30 days of the	
Well Owner Information Owner Name: Robbie CArNA- Mailing Address: 205 N. Buc	on than kingham	Well Latitude: Method of Lat/Long (circle one	Location	
OKulowa M City State Telephone No. (662 447 - 39		$\frac{4 \text{ Sec } 23}{\text{Distance}}$ $\frac{3 \text{ Miles}}{2}$	Twn <u>125</u> Rng <u>55</u> Nearest Town	
Pump Type Circle one	Circle one		Power Type Circle one	
Bucket	Submersible	Diesel Engine Gasoline	Engine Natural Gas	
Centrifugal	Furbine	Electric Motor Hand	Tractor PTO	
Other (specify):	Flowing Well		Decify):	
Date Pump Installed: 6-(7-08 Rated Pump Capacity: 12 G		Horse Power Rating of Motor: Setting Depth:/ 6 & Number of Stages:/4	fect	
Pump Test Data Date Well Tested:		Method of Measuring Water Level Circle one		
Static Water Level (A):Feet Below Land Surface Pumping Water Level (B):Feet Below Land Surface		Air Line Electric Measuring Line Steel Tape . Other (specify):		
Drawdown [(B) – (A)]:Feet Below Land Surface		For flowing well, measured shut i	n bead:	
Test Pumping Rate:Gallons Per Minute		For flowing well, measured shut in head:feet Well yieldedGPM with a drawdown of		
Duration of Pump Test (minimum 4 hours):	hours		hours of pumping	
HEREBY CERTIFY that the above statements Leeper Drilling Print Name of Pump Installer and License No. (0079	f my knowledge. Signature of Pump Instal		

-

Î

.

.

RECEIVED JUL 07 2008 BY: OLWR