

CHICKASAW MISSISSIPPI BOARD OF WATER COMMISSIONERS

TE8

WATER WELL DRILLERS LOG

CODED

1-15-62

Date: Jan 15, 1962, Driller: Sam P. Smith County Chickasaw
(Name)

(1) Owner of Land: <u>SAM Schwabenberg</u> (Name)	Description & Color of Materials Sand, Clay, Red Clay, Shell, etc.	Thick- ness Feet	Depth Feet
<u>Star Route, Houston, Miss.</u> (Address)	<u>Red Clay/Lime</u>	<u>30</u>	<u>30</u>
(2) Location: <u>29th 135th E</u> 1/4, Sec. <u>1 R</u>	<u>Lime Stream</u>	<u>30</u>	<u>40</u>
<u>5</u> miles <u>West</u> of <u>Houston</u> (distance) (direction) (Nearest Town)	<u>Black Shale</u>	<u>40</u>	<u>70</u>
(3) Topography: <input checked="" type="checkbox"/> (Hilly) <input type="checkbox"/> (Flat) <input type="checkbox"/> (Level)	<u>Blue Gumbo</u>	<u>70</u>	<u>175</u>
(4) Purpose of Well: <u>Domestic</u> (Domestic Irrigation Municipal, Industrial, Other)	<u>Shale</u>	<u>175</u>	<u>250</u>
	<u>Blue Gumbo</u>	<u>250</u>	<u>280</u>
	<u>Shale & Gumbo</u>	<u>280</u>	<u>300</u>
	<u>Drilled in Sand</u>	<u>300</u>	<u>315</u>

Information upon completion of well:

(1) Diameter 4 inches.

(2) Total Depth 315 feet.

(3) Water Level 90 feet below top of ground.

(4) Cased to 84 ft., Size 4"

(5) Screen: Size _____, Length _____.


(6) Were any formations sealed against pollution?
 yes, _____ no.

If YES, depth of formation 30 ft.

Why Surface Stream

Drillers Remarks: + Lime

CODED

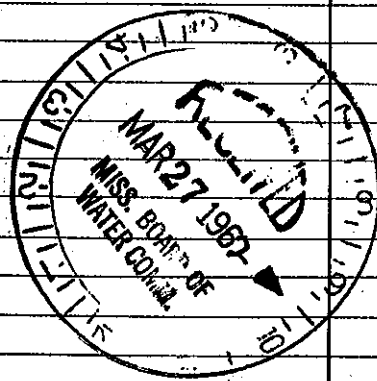

Well No.

(Use Back Side)

Mail this copy to Board of Water Commissioners 429 Miss. St. Jackson, Miss