

MISSISSIPPI BOARD OF WATER COMMISSIONERS
CODED

~~CHICK.~~

E 10 WATER WELL DRILLERS LOG

CODED

Date: Feb 7, 1964, Driller: Sam Smith County Chick.

(Name)

(1) Owner of Land: <u>Murphy</u> (Name)	Description & Color of Materials Sand, Clay, Red Clay, Shell, etc.	Thick- ness Feet	Depth Feet
(Address) <u>10 13528</u>	<u>0-20 Red clay</u>		
(2) Location: <u>1/4, 1/4, Sec. T R</u>	<u>20-70 Blk. Sh. Blue clay</u>		
<u>5</u> miles <u>North W.</u> of <u>Houston</u> (distance) (direction) (Nearest Town)	<u>70-250 - White clay</u>		
(3) Topography: <u>✓</u> (Hilly) (Flat) (Level)	<u>250-300 ft Wilcox s.s.</u>		
(4) Purpose of Well: <u>Domestic</u> (Domestic Irrigation Municipal, Industrial, Other)			


~~CANNOT
 BE
 USED~~

Information upon completion of well:

- (1) Diameter 4 inches.
- (2) Total Depth 300 feet.
- (3) Water Level 100 feet below top of ground.
- (4) Cased to 84, Size _____
- (5) Screen: Size none, Length _____
- (6) Were any formations sealed against pollution?
 yes, no.

If YES depth of formation 0-40
 Why lime formation

Drillers Remarks:
1 h.p. Dempster
Jet

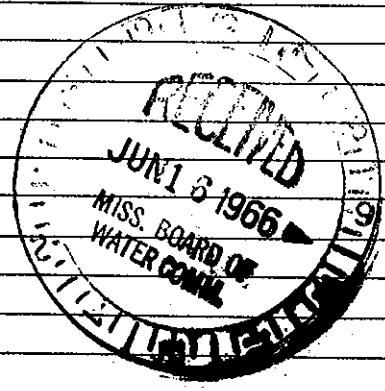

Well No.

(Use Back Side)

Mail this copy to Board of Water Commissioners 429 Miss. St. Jackson, Miss.