

CHICK.
WELL
3-26-63

MISSISSIPPI BOARD OF WATER COMMISSIONERS

WATER WELL DRILLERS LOG

CODED

Date: 3-26, 1963, Driller: Sam F. Smith County Chickasaw

(Name)

		Description & Color of Materials Sand, Clay, Red Clay, Shell, etc.	Thick- ness Feet	Depth Feet
(1) Owner of Land: <u>Evans</u> (Name)		Top Soil, clay thin	0	30
<u>State Route, Houston</u> (Address)		lime & shale	30	60
(2) Location: $\frac{1}{4}$, <u>20 1352E</u> $\frac{1}{4}$, Sec. T. R.		Spale blue clay	60	90
<u>5 1/2</u> miles <u>West</u> , of <u>Houston</u> (distance) (direction) (Nearest Town)		blue clay	90	180
(3) Topography: _____ (Hilly) (Flat) (Level)		white clay	170	350
(4) Purpose of Well: <u>Domestic</u> (Domestic Irrigation Municipal, Industrial, Other)		water sand	330	340

Information upon completion of well:


- (1) Diameter 4 inches.
- (2) Total Depth 340 feet.
- (3) Water Level 110 feet below top of ground.
- (4) Cased to 84, Size 4"
- (5) Screen: Size _____, Length _____
- (6) Were any formations sealed against pollution?
 yes, _____ no.

If YES depth of formation 60 feet

Why limestone formation

Drillers Remarks:

CODED

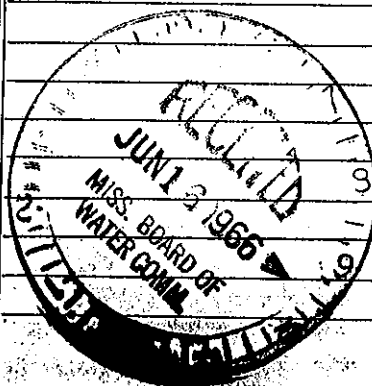

(Use Back Side)

Well No.

Mail this copy to Board of Water Commissioners 429 Miss. St. Jackson, Miss