

CHICK
E12
5-63

MISSISSIPPI BOARD OF WATER COMMISSIONERS

WATER WELL DRILLERS LOG

CODED

Date: 5-19-63, Driller: Sam Smith County Chickasaw

(Name)

(1) Owner of Land: <u>Allen Weldridge</u> (Name)	Description & Color of Materials Sand, Clay, Red Clay, Shell, etc.	Thick- ness Feet	Depth Feet
<u>Star Route</u> (Address)	<u>0-20 Red clay</u>		
(2) Location: <u>10 135 28</u> 1/4, 1/4, Sec. T R	<u>20-90 Blk. sh. & blue clay</u>		
<u>4 miles west</u> of <u>Houston</u> (distance) (direction) (Nearest Town)	<u>90-290 - white clay</u>		
(3) Topography: <u>Flat</u> (Hilly) (Flat) (Level)	<u>Sand 290-300 ?</u>		
(4) Purpose of Well: <u>Domestic</u> (Domestic Irrigation Municipal, Industrial, Other)			

CODED


Information upon completion of well:

- (1) Diameter 4 inches.
- (2) Total Depth 300 feet.
- (3) Water Level 100 feet below top of ground.
- (4) Cased to 105, Size 4
- (5) Screen: Size _____, Length _____
- (6) Were any formations sealed against pollution?
yes, _____ no.

If YES depth of formation 0-50

Why Sam Smith

Drillers Remarks:

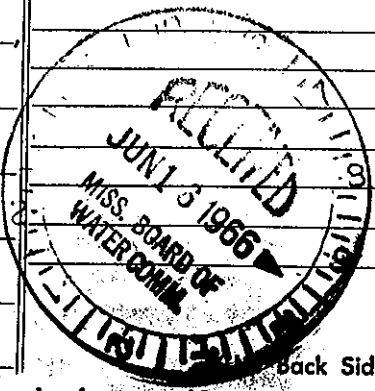

Well No.

Mail this copy to Board of Water Commissioners 429 Miss. St. Jackson, Miss