

CHICK. 15
E 15
8-20-63

MISSISSIPPI BOARD OF WATER COMMISSIONERS

WATER WELL DRILLERS LOG

CODED

Date Aug. 20, 1963, Driller: Sam P. Smith County Chickasaw
(Name)

(1) Owner of Land: <u>Bud Loran</u> (Name)	Description & Color of Materials Sand, Clay, Red Clay, Shell, etc.	Thick- ness Feet	Depth Feet
<u>State Route</u> (Address)	<u>0-20 Surface</u>		
(2) Location: <u>1/4, 10, 13529</u> R	<u>20-70 blk. sh. blue clay</u>		
<u>5 miles</u> <u>West</u> of <u>Houston</u> (distance) (direction) (Nearest Town)	<u>70-290 white clay</u>		
(3) Topography: <input checked="" type="checkbox"/> (Hilly) <input type="checkbox"/> (Flat) <input type="checkbox"/> (Level)	<u>290-300 white clay</u>		
(4) Purpose of Well: <u>Domestic</u> (Domestic Irrigation, Municipal, Industrial, Other)			

CODED

Information upon completion of well:

(1) Diameter 4 inches.

(2) Total Depth 300 feet.

(3) Water Level 100 feet below top of ground.

(4) Cased to 84, Size _____.


(5) Screen: Size _____, Length _____.

(6) Were any formations sealed against pollution?
 yes, _____ no.

If YES depth of formation 8-30

Why _____

Drillers Remarks: _____

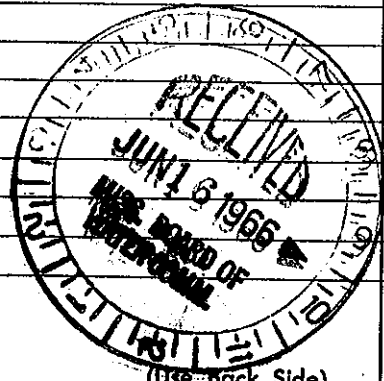

Well No.

Mail this copy to Board of Water Commissioners 429 Miss. St. Jackson, Miss.