

CHICK,
E 16
1-64

MISSISSIPPI BOARD OF WATER COMMISSIONERS

CODED

V.P

WATER WELL DRILLERS LOG

~~CODED~~

Date: Jan, 1964, Driller: Sam P. Smith County, Chickasaw

(Name)

(1) Owner of Land: <u>Marvin Fleming</u> (Name)	Description & Color of Materials Sand, Clay, Red Clay, Shell, etc.	Thick- ness Feet	Depth Feet
<u>Star Route</u> (Address)	<u>0-20 Red clay</u>		
(2) Location: $\frac{1}{4}$, <u>29 138 2E</u> , $\frac{1}{4}$ Sec. <u>T R</u>	<u>20-70 Blk. Sh. Blue clay</u>		
<u>5</u> miles <u>West</u> , of <u>Houston</u> (distance) (direction) (Nearest Town)	<u>70-310 White clay</u>		
(3) Topography: <input checked="" type="checkbox"/> (Hilly) <input type="checkbox"/> (Flat) <input type="checkbox"/> (Level)	<u>310-330 white sh.</u>		
(4) Purpose of Well: <u>Domestic</u> (Domestic Irrigation Municipal, Industrial, Other)			

~~CODED~~

Information upon completion of well:

(1) Diameter 4 inches.

(2) Total Depth 330 feet.

(3) Water Level 105 feet below top of ground.

(4) Cased to 84, Size _____


(5) Screen: Size _____, Length _____

(6) Were any formations sealed against pollution?
 yes, no.

If YES depth of formation 0-140

Why lime formation

Drillers Remarks:
Red Pump

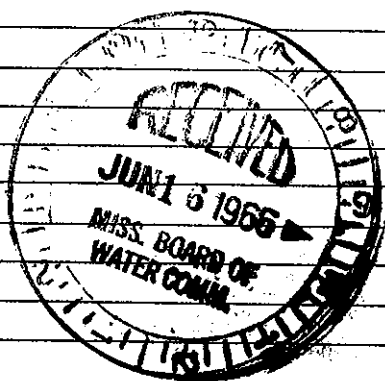

Well No.

(Use Back Side)

Mail this copy to Board of Water Commissioners 429 Miss. St. Jackson, Miss.