


CHICKASAW

E 2000

4-10-62

MISSISSIPPI BOARD OF WATER COMMISSIONERS
416 North State Street
Jackson, Mississippi

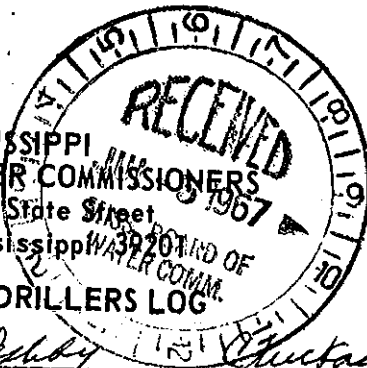

WATER WELL DRILLERS LOG

4-10-62 date well completed
R S Deby firm name
Chickasaw county well located

LANDOWNER: Walton B Leonard

H Austin Miss

R S D.

(mailing address)

WELL LOCATION:

sec 29 T13 N R 20 W
7 miles West of Houston
(distance) (direction) (nearest town)

WELL PURPOSE: Home
(home, irrigation, municipal, industrial)


WELL COMPLETION DATA:

- (1) diameter (inches) 3 7/8
- (2) total depth (feet) 351.6'
- (3) static water level (feet) 50 below above top of ground.
- (4) casing 106-8 (material) (depth)
(size) If telescope see back.
- (5) screen (length) (depth to top)
(size) (material)
- (6) pump 3/4 HP 6-90 (HP) (yield gpm)
Electric (type power)
- (7) electric log none (yes or no)
(organization running log)
- (8) how well bottom plugged Perfect
Pipe

description of formations encountered

from to

surface soil	0	10'
gray shale	10	105
" "	105	266
lime rock	266	319
cap rock hard sand		
rock		
shale	319	356

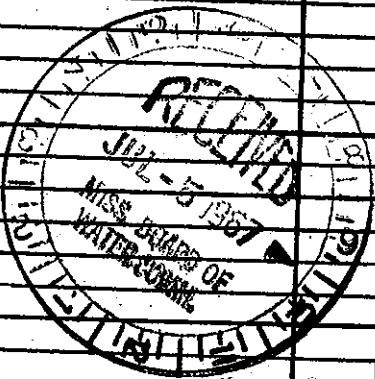

DRILLERS REMARKS: 168.2 gals
in bit of well 42' low
bit and plug & plugged bit and