

CHICKASAW MISSISSIPPI BOARD OF WATER COMMISSIONERS

F-20
5-6-64

CODE

WATER WELL DRILLERS LOG

9/18/64
COPPED
DOSED

Date: May 6, 19 64, Driller: Layne-Central Company County Chickasaw

(Name)

U.S. Department of Agriculture

(1) Owner of Land: Trace Work Center
(Name)
Houston, Mississippi
1 1/2 miles west of Trace Parkway
on Highway 32.
(2) Location: NW 1/4, NE 1/4, Sec. 1 T13R3
1 1/2 miles west of Trace Parkway
(distance) (direction) (Nearest Town)

(3) Topography: hilly
(Hilly) (Flat) (Level)

(4) Purpose of Well: domestic
(Domestic Irrigation
Municipal, Industrial, Other)

Description & Color of Materials Sand, Clay, Red Clay, Shell, etc.	Thick- ness Feet	Depth Feet
Red Sandy clay	14	14
Blue clay	4	18
Lime stone	20	38
Clay	86	124
Shale	6	150
Clay	26	164
Hard shale	61	225
White clay	50	275
Lime stone	285	560
Clay	37	597
Rock	9	606
Shaly clay	116	722
Fine sand strks. shale	176	898
Sand	57	955
Rock	1	956
Clay	5	961

Information upon completion of well:

(1) Diameter 6x4 inches.

(2) Total Depth 961 feet.

(3) Water Level 177' 8" feet below top of ground.
41' -5" 4" galv.



(4) Cased to 871' -3" Size 6"
28' -9" lap 4"

(5) Screen: Size 4" Length 41' -2"
4' -6" B.P.V. 4"
2' of 4" Tail Pipe

(6) Were any formations sealed against pollution?
yes yes, no no.

If YES depth of formation Packer above the
screen, mechanical seal above the
blank and B.P.V. at bottom.
Why _____

Drillers Remarks: _____

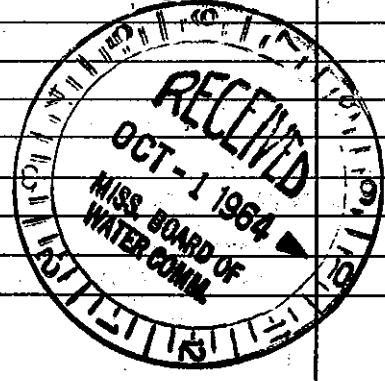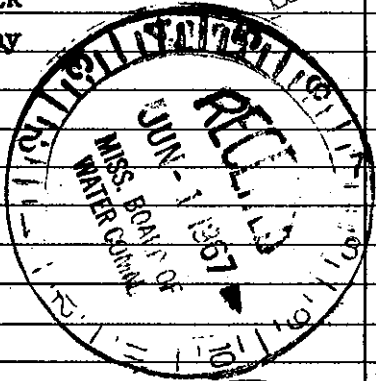

(Use Back Side)

Well No.

Mail this copy to Board of Water Commissioners 429 Miss. St. Jackson, Miss.